


SANTRAGACHI STATION YARD

KM : 7.446 F/HWH



CSB. OF SANTRAGACHI STN. BUILDING
CSB CH: 0.00M

REF DRG. NO. : C.E.'s No. YD/SY/29405/23

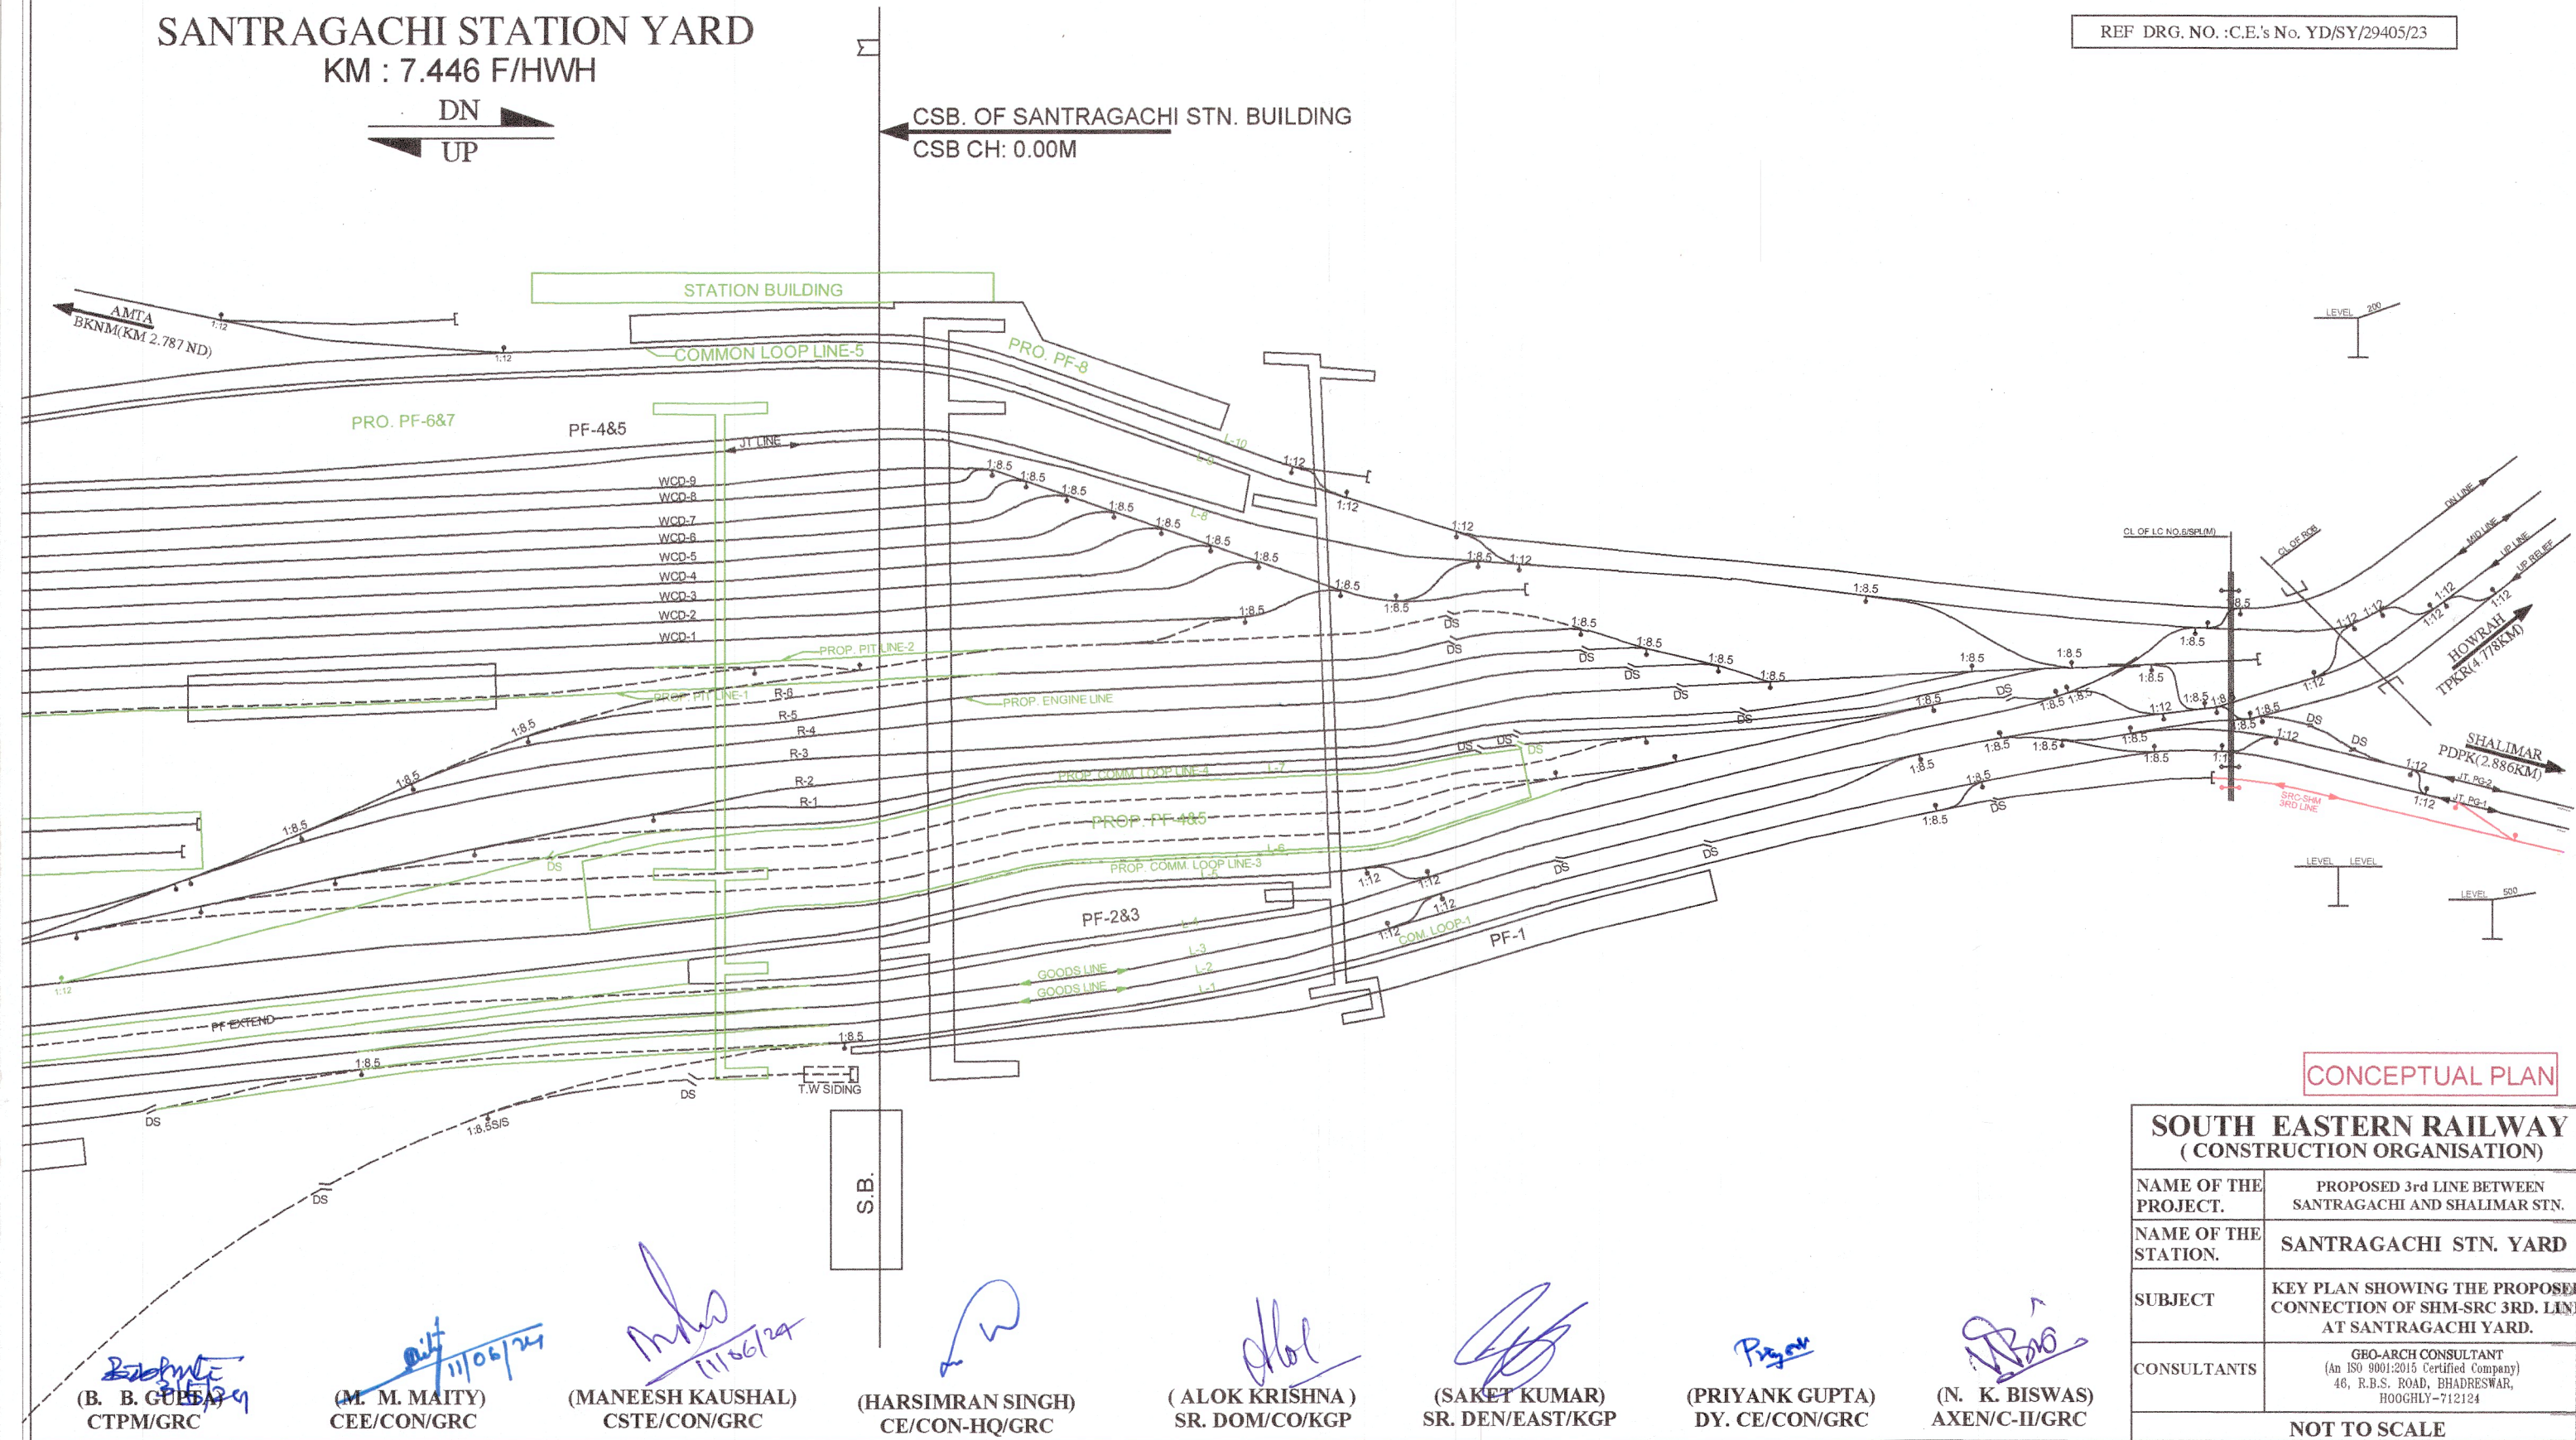

CONCEPTUAL PLAN

SOUTH EASTERN RAILWAY (CONSTRUCTION ORGANISATION)

NAME OF THE PROJECT.	PROPOSED 3rd LINE BETWEEN SANTRAGACHI AND SHALIMAR STN.
NAME OF THE STATION.	SANTRAGACHI STN. YARD
SUBJECT	KEY PLAN SHOWING THE PROPOSED CONNECTION OF SHM-SRC 3RD. LINE AT SANTRAGACHI YARD.
CONSULTANTS	GEO-ARCH CONSULTANT (An ISO 9001:2015 Certified Company) 46, R.B.S. ROAD, BHADRESWAR, HOOGHLY-712124
NOT TO SCALE	

(B. B. GUPTA)
CTPM/GRC

(M. M. MAITY)
CEE/CON/GRC

(MANEESH KAUSHAL)
CSTE/CON/GRC

(HARSIMRAN SINGH)
CE/CON-HQ/GRC


(ALOK KRISHNA)
SR. DOM/CO/KGP

(SAKET KUMAR)
SR. DEN/EAST/KGP

(PRIYANK GUPTA)
DY. CE/CON/GRC

(N. K. BISWAS)
AXEN/C-II/GRC

PADMAPUKUR K.M.-10.332

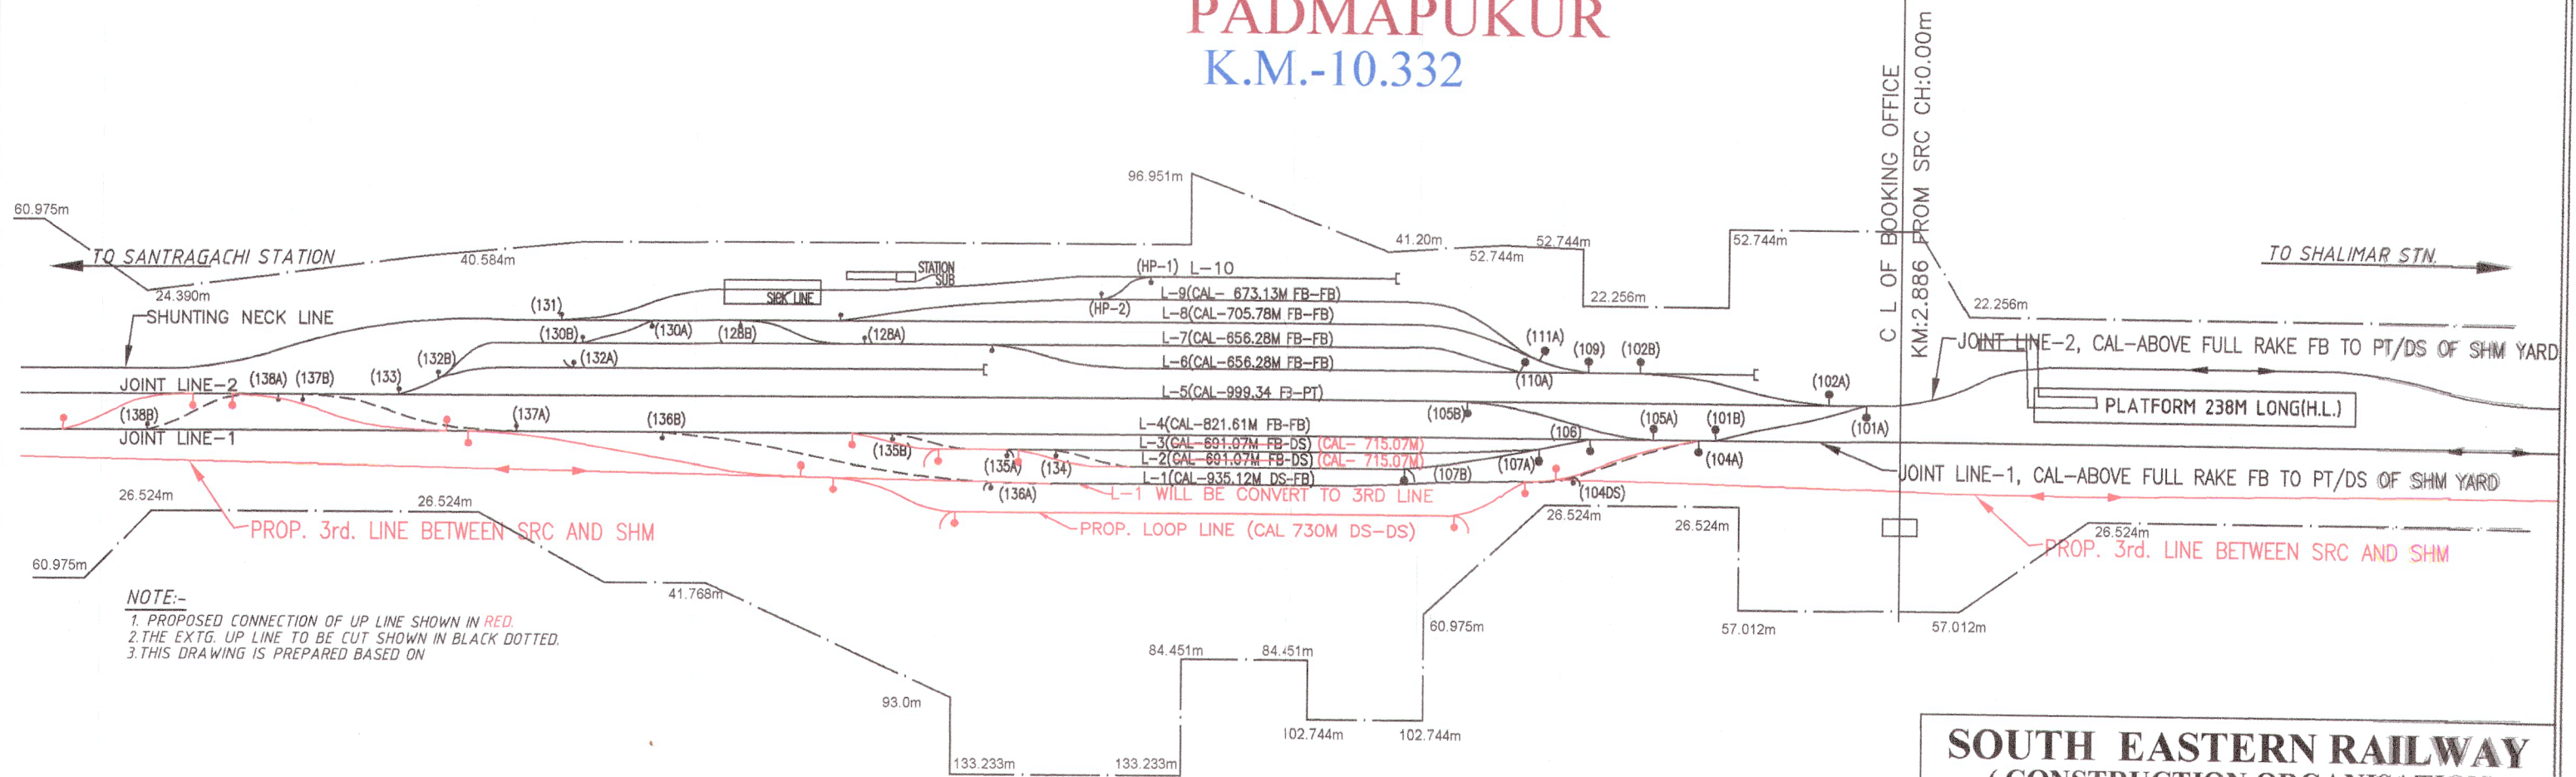

SOUTH EASTERN RAILWAY (CONSTRUCTION ORGANISATION)

NAME OF THE PROJECT.	PROPOSED 3rd LINE BETWEEN SANTRAGACHI AND SHALIMAR STN.
NAME OF THE STATION.	PADMAPUKUR STN. YARD
SUBJECT	KEY PLAN SHOWING THE PROPOSED CONNECTION OF SHM-SRC 3RD. LINE AT PADMAPUKUR YARD.
CONSULTANTS	GEO-ARCH CONSULTANT (An ISO 9001:2015 Certified Company) 46, R.B.S. ROAD, BHADRESWAR, HOOGHLY-712124

NOT TO SCALE

B. B. Gupta
21/06/24
(B. B. GUPTA)
CTPM/GRC

M. M. Maity
11/06/24
(M. M. MAITY)
CEE/CON/GRC

Maneesh Kaushal
11/06/24
(MANEESH KAUSHAL)
CSTE/CON/GRC

Harsimran Singh
(HARSIMRAN SINGH)
CE/CON-HQ/GRC

Alok Krishna
(ALOK KRISHNA)
SR. DOM/CO/KGP

Saket Kumar
(SAKET KUMAR)
SR. DEN/EAST/KGP


Priyank Gupta
(PRIYANK GUPTA)
DY. CE/CON/GRC

N. K. Biswas
(N. K. BISWAS)
AXEN/C-II/GRC

TO SANTRAGACHI STN.

SHALIMAR
K.M.-12.516

RIVER HOOGHLY SIDE

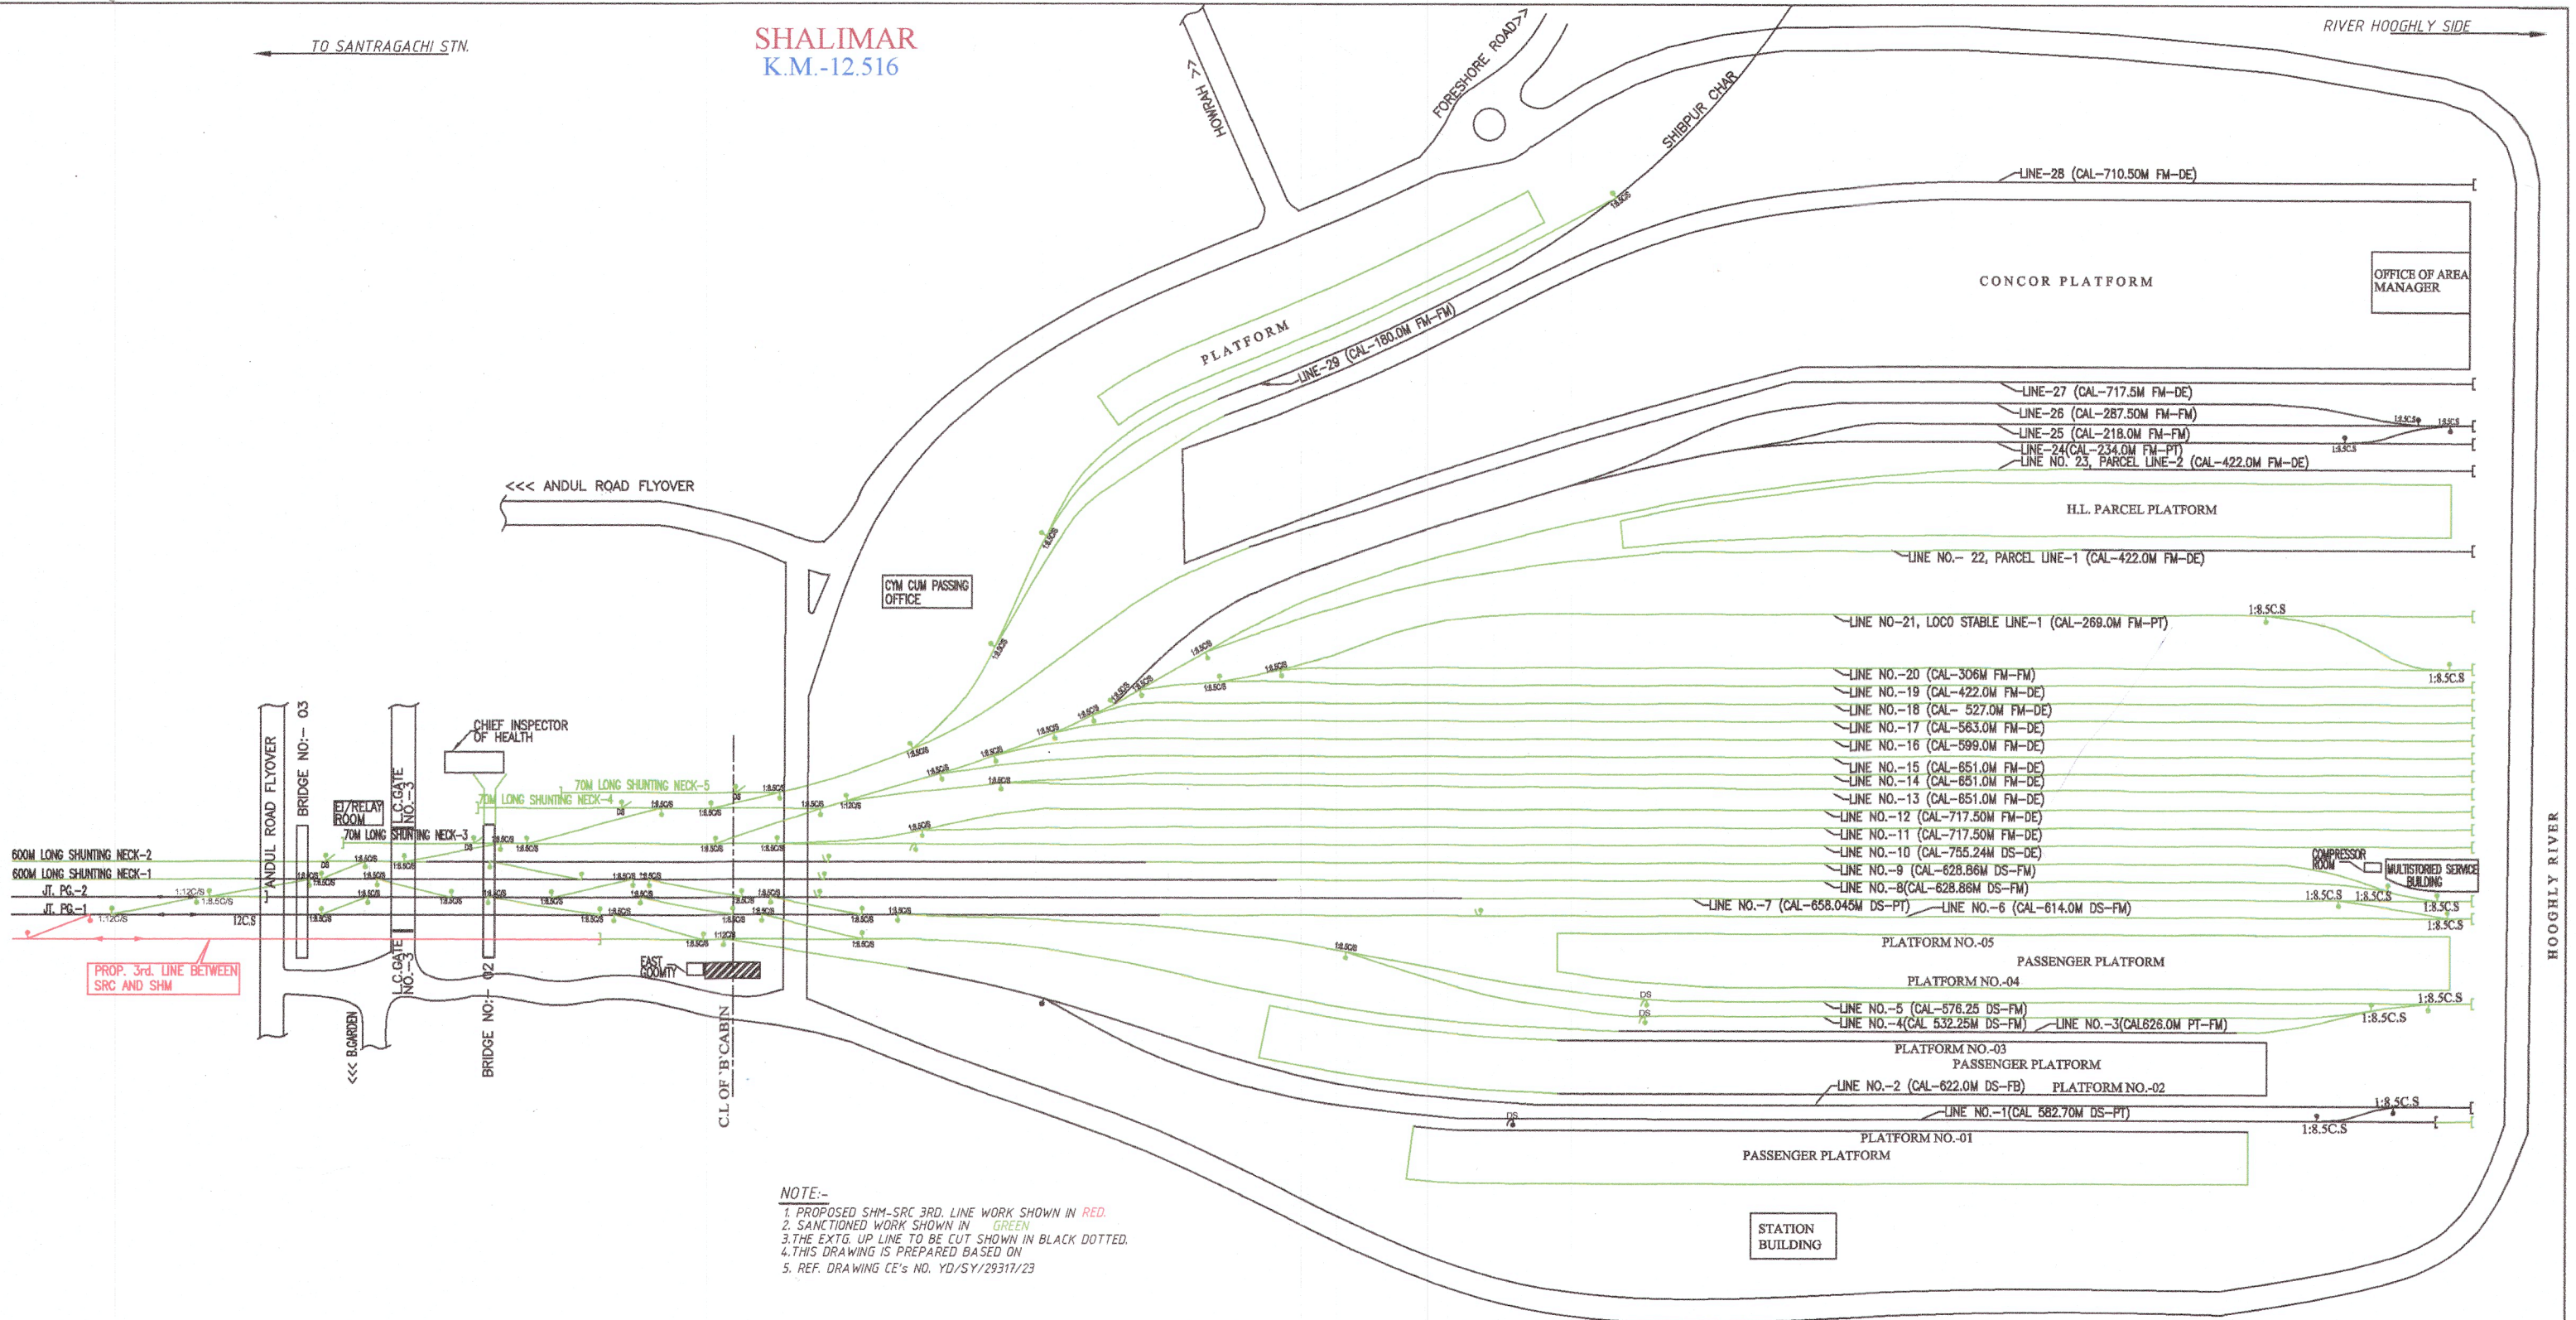

NOTE:-
1. PROPOSED SHM-SRC 3RD. LINE WORK SHOWN IN RED.
2. SANCTIONED WORK SHOWN IN GREEN
3. THE EXTG. UP LINE TO BE CUT SHOWN IN BLACK DOTTED.
4. THIS DRAWING IS PREPARED BASED ON
5. REF. DRAWING CE'S NO. YD/SY/29317/23

B. B. Gupta
(B. B. GUPTA)
CTPM/GRC

M. M. Matty
(M. M. MATTY)
CEE/CON/GRC

Maneesh Kaushal
(MANEESH KAUSHAL)
CSTE/CON/GRC

Harsimran Singh
(HARSIMRAN SINGH)
CE/CON-HQ/GRC

Alok Krishna
(ALOK KRISHNA)
SR. DOM/CO/KGP

Saket Kumar
(SAKET KUMAR)
SR. DEN/EAST/KGP

Priyank Gupta
(PRIYANK GUPTA)
DY. CE/CON/GRC

N. K. Biswas
(N. K. BISWAS)
AXEN/C-II/GRC

SOUTH EASTERN RAILWAY (CONSTRUCTION ORGANISATION)	
NAME OF THE PROJECT.	PROPOSED 3rd LINE BETWEEN SANTRAGACHI AND SHALIMAR STN.
NAME OF THE STATION.	SHALIMAR STN. YARD
SUBJECT	KEY PLAN SHOWING THE PROPOSED CONNECTION OF SHM-SRC 3RD. LINE AT SHALIMAR YARD.
CONSULTANTS	GEO-ARCH CONSULTANT (An ISO 9001:2015 Certified Company) 46, P.B.S. ROAD, BHADRESWAR, HOOGHLY-712124
NOT TO SCALE	