


1. PROPOSED WORKS OF RGP-ADTP 3rd LINE SHOWN IN RED
2. THE WORKS TO BE DISMANTLED SHOWN IN HLCAC DOTTED.
3. EXISTING WORKS HAVE BEEN SHOWN IN BLACK FIRM LINES.
4. THIS DRAWING IS PREPARED BASED ON CE's No. YD/SY/28388/80, REV-1
5. PROPOSED WORKS OF ADTP-JOKEN 4th LINE SHOWN IN MAGENTA COLOUR
6. ADDITIONAL 3RD LINE SHOWN IN BLUE COLOUR

~~Subsonic~~
Subsonic (center)
for CTPTM
14/11/24

<p><i>50</i> <i>4 Low</i> <i>for CTRM</i> <i>14/11/29</i></p>				<p><i>14/11/29</i></p>				<p><i>18/11/29</i></p>				<p><i>2</i></p>			
CTRM/COR				COR/COR/COR				CSTR/COR/COR				CS/SOUTER/COR/COR			
NAME OF PROJECT				ADDP-ROSC PROP, 4th LINE WORKS				NAME OF STATION				CONCEPTUAL YARD PLAN			
				TATA - ADPP PROP 3rd LINE WORKS								ADITYAPUR STATION			
												KRI. 53.904 FROM 11th VIATATA)			
												NOT TO SCALE			

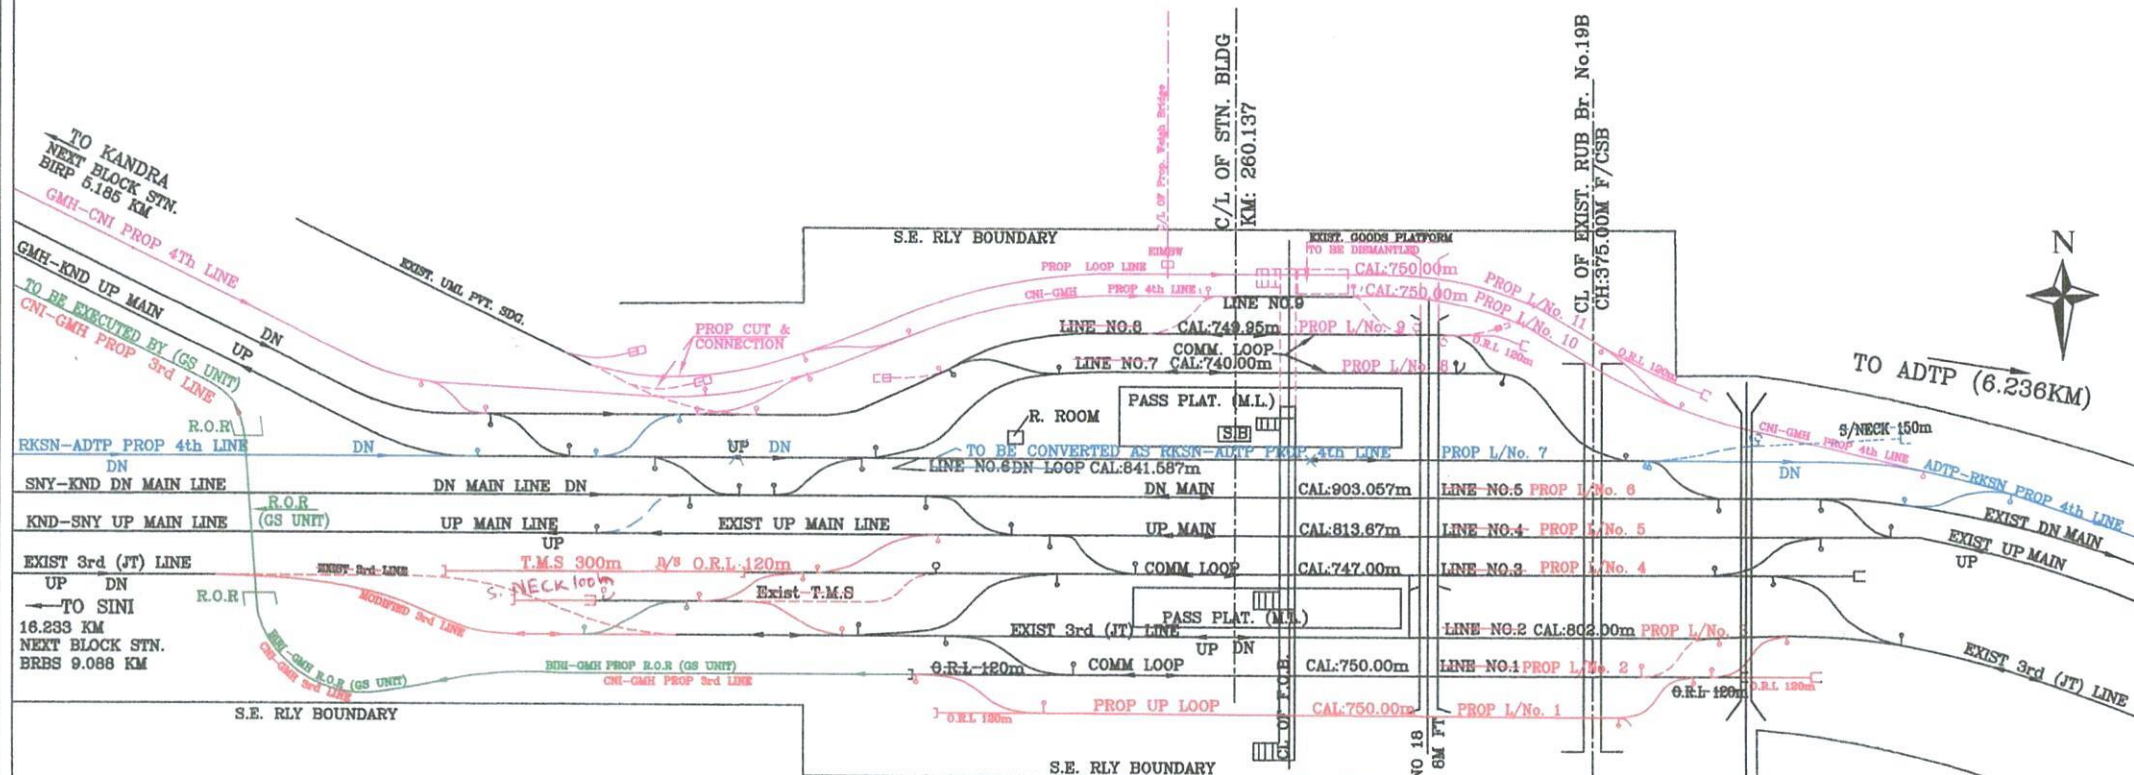

LEGENDS:

1. ALL EXIST. WORKS SHOWN AS
2. EXIST. WORKS TO BE DISMANTLED FOR BIRP-GMH FLY OVER LINE WORKS BY GS UNIT
3. PROP. BIRP-GMH FLY OVER LINE WORKS BY GS UNIT
4. EXIST. WORKS TO BE DISMANTLED FOR PROP. ADTP-RKS-N 4th LINE WORKS
5. PROP. ADTP-RKS-N 4th LINE WORKS
6. EXIST. WORKS TO BE DISMANTLED FOR CNI-GMH 3rd LINE
7. PROP. CNI-GMH 3rd LINE WORKS
8. EXIST. WORKS TO BE DISMANTLED FOR CNI-GMH 4th LINE
9. PROP. CNI-GMH 4th LINE WORKS SHOWN AS

IMPORTANT NOTES:-

1. PROP. BIRP-GMH FLY OVER LINE WORKS BEING DONE BY GS UNIT HAS BEEN MERGD WITH PROP. CNI - GMH 3rd LINE.
2. CAL OF ALL EXIST. & PROP. LINES ARE TO BE MORE THAN 750m EXCEPT CAL OF PROP L/No. 8, WHICH IS 740m AS EXIST.
3. PROP. ELEVATED CORRIDOR FROM GMH TO KND IN CONNECTION WITH PROP. CNI - GMH 3rd LINE HAS BEEN MERGD WITH PROP. ROR BY GS UNIT.

B. S. Indli
31/4/24
CTPM/GRC

CEE/CON/GRC

CSTE/CON/GRC

CE/CON/HQ/GRC

REF: CE's DRG No. YD/SY/26567/12 REV-5

SOUTH EASTERN RAILWAY

NAME OF
PROJECT


CNI - GMH PROP. 3rd LINE, 4th LINE &
ADTP-RKS-N PROP. 4th LINE
BIRP - GMH FLY OVER LINE OF GS UNIT

NAME OF
STATION

CONCEPTUAL YARD PLAN
GAMAHARIA STATION
KM. 260.137 (FROM IHVIA VIA TATA)

Dated 26.03.2024

NOT TO SCALE

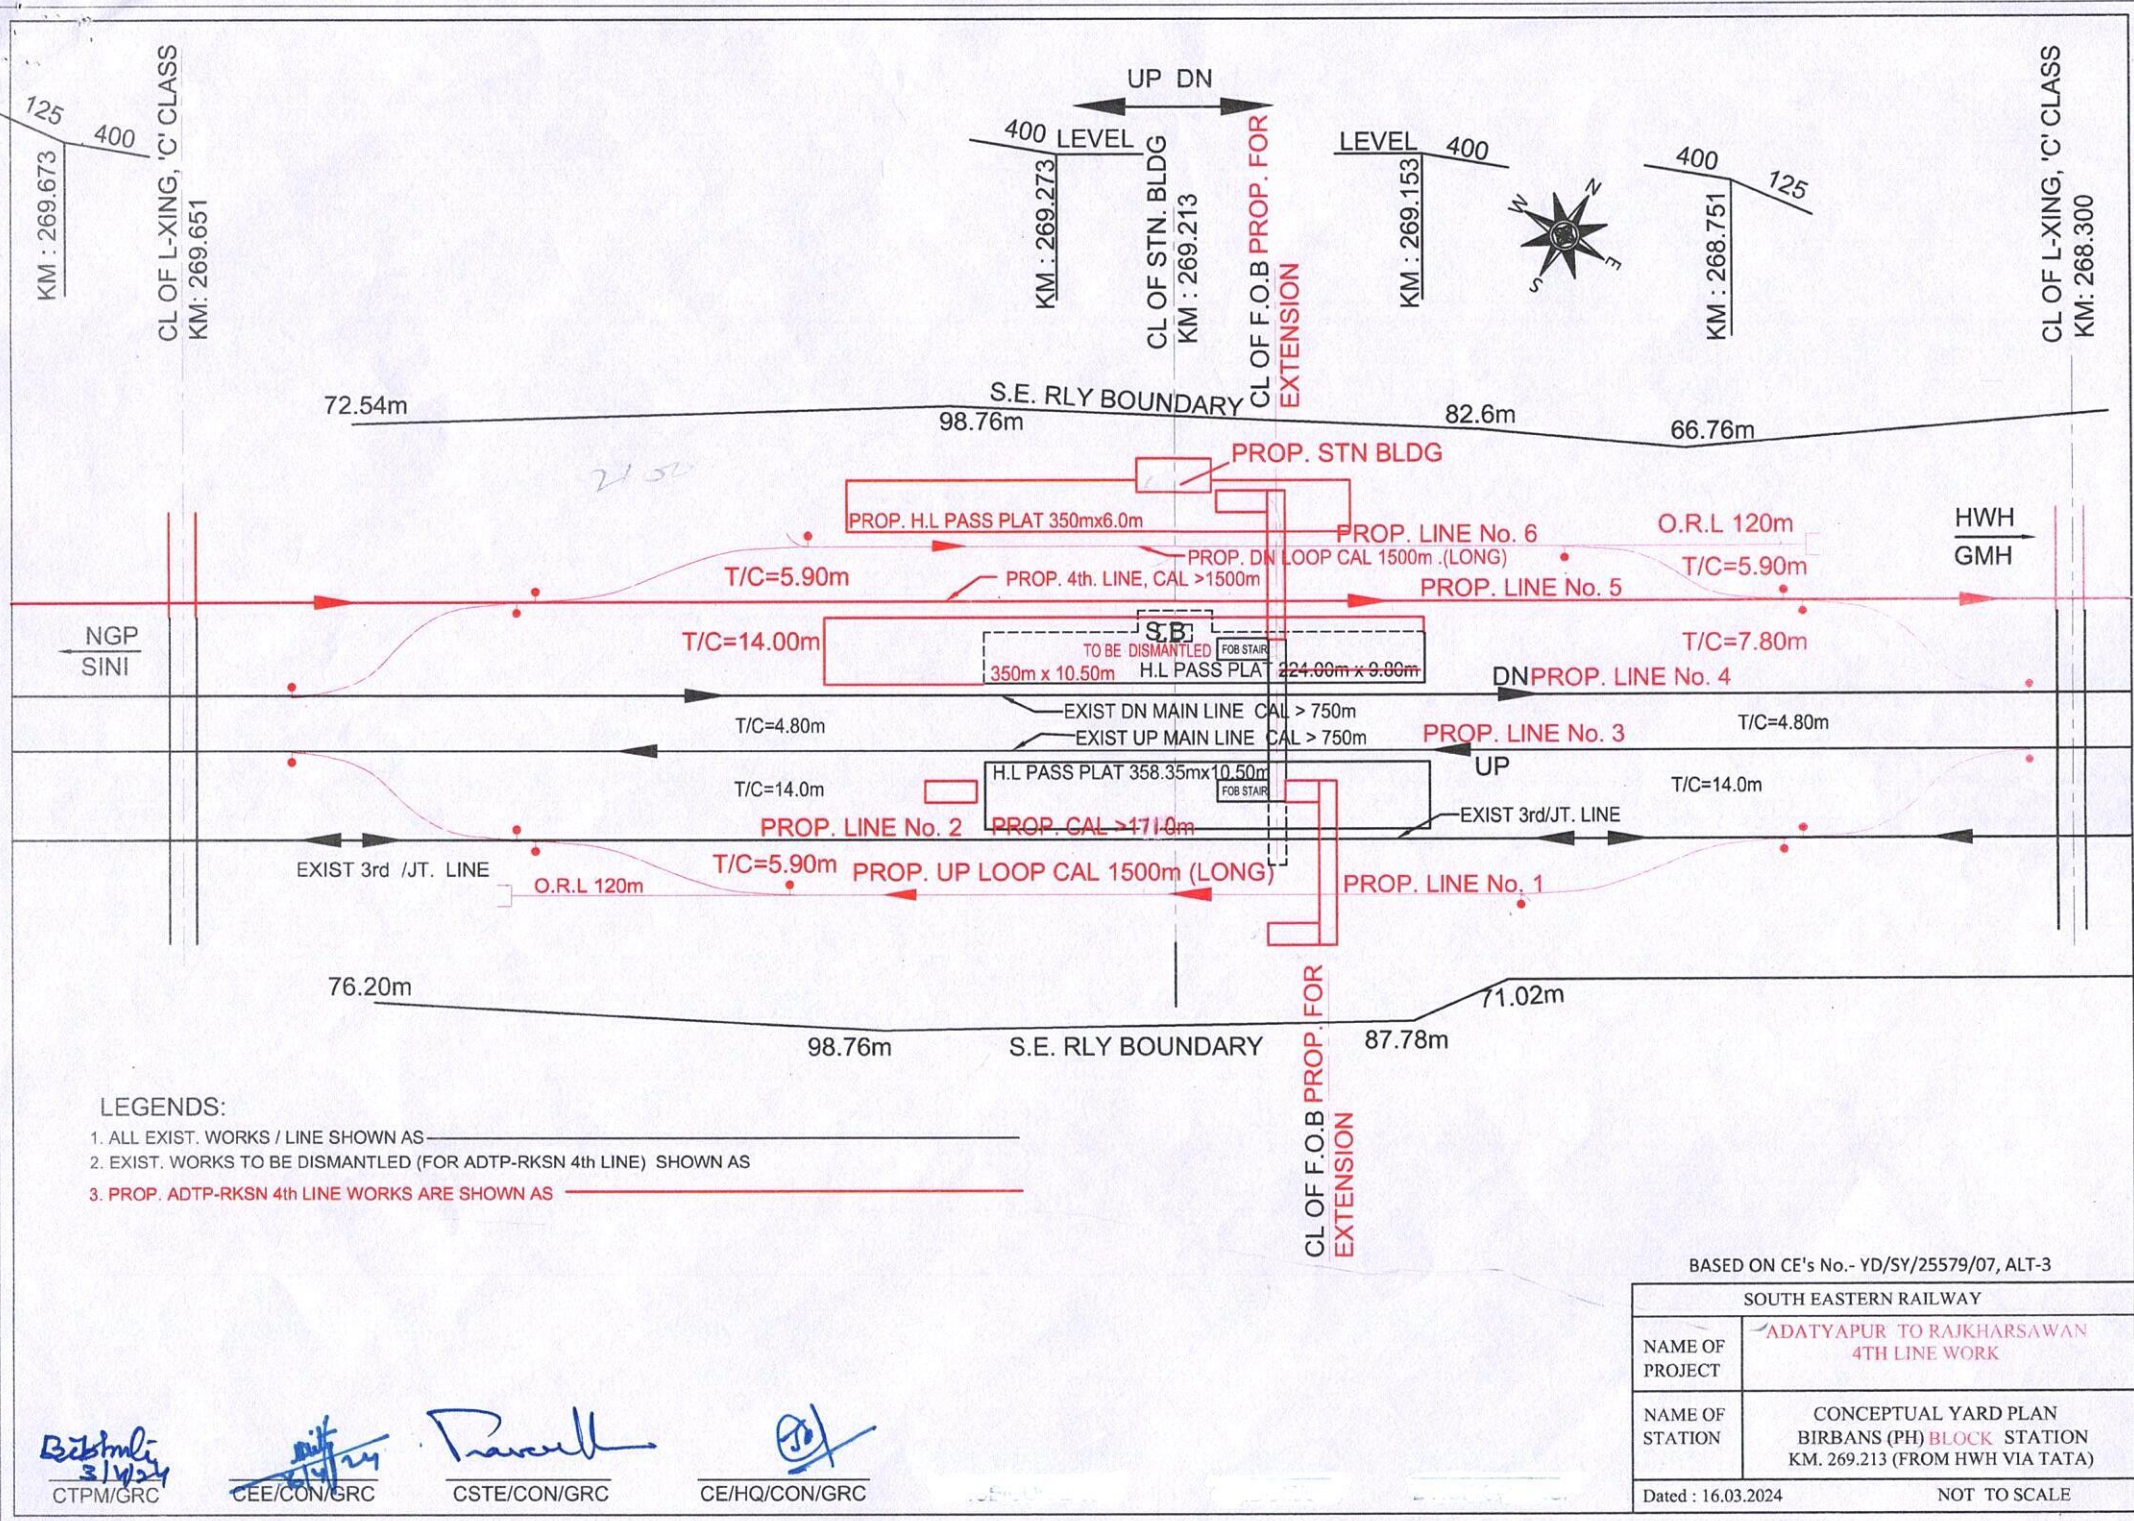

LEGENDS:

1. ALL EXIST. WORKS / LINE SHOWN AS _____
2. EXIST. WORKS TO BE DISMANTLED (FOR ADTP-RKSN 4th LINE) SHOWN AS _____
3. PROP. ADTP-RKSN 4th LINE WORKS ARE SHOWN AS _____

BASED ON CE's No.- YD/SY/25579/07, ALT-3


SOUTH EASTERN RAILWAY	
NAME OF PROJECT	ADATYAPUR TO RAJKHARSAN 4TH LINE WORK
NAME OF STATION	CONCEPTUAL YARD PLAN BIRBANS (PH) BLOCK STATION KM. 269.213 (FROM HWH VIA TATA)
Dated : 16.03.2024 NOT TO SCALE	

Birbans
3/1/24
CTPM/GRC

CEE/CON/GRC

CSTE/CON/GRC

CE/HQ/CON/GRC

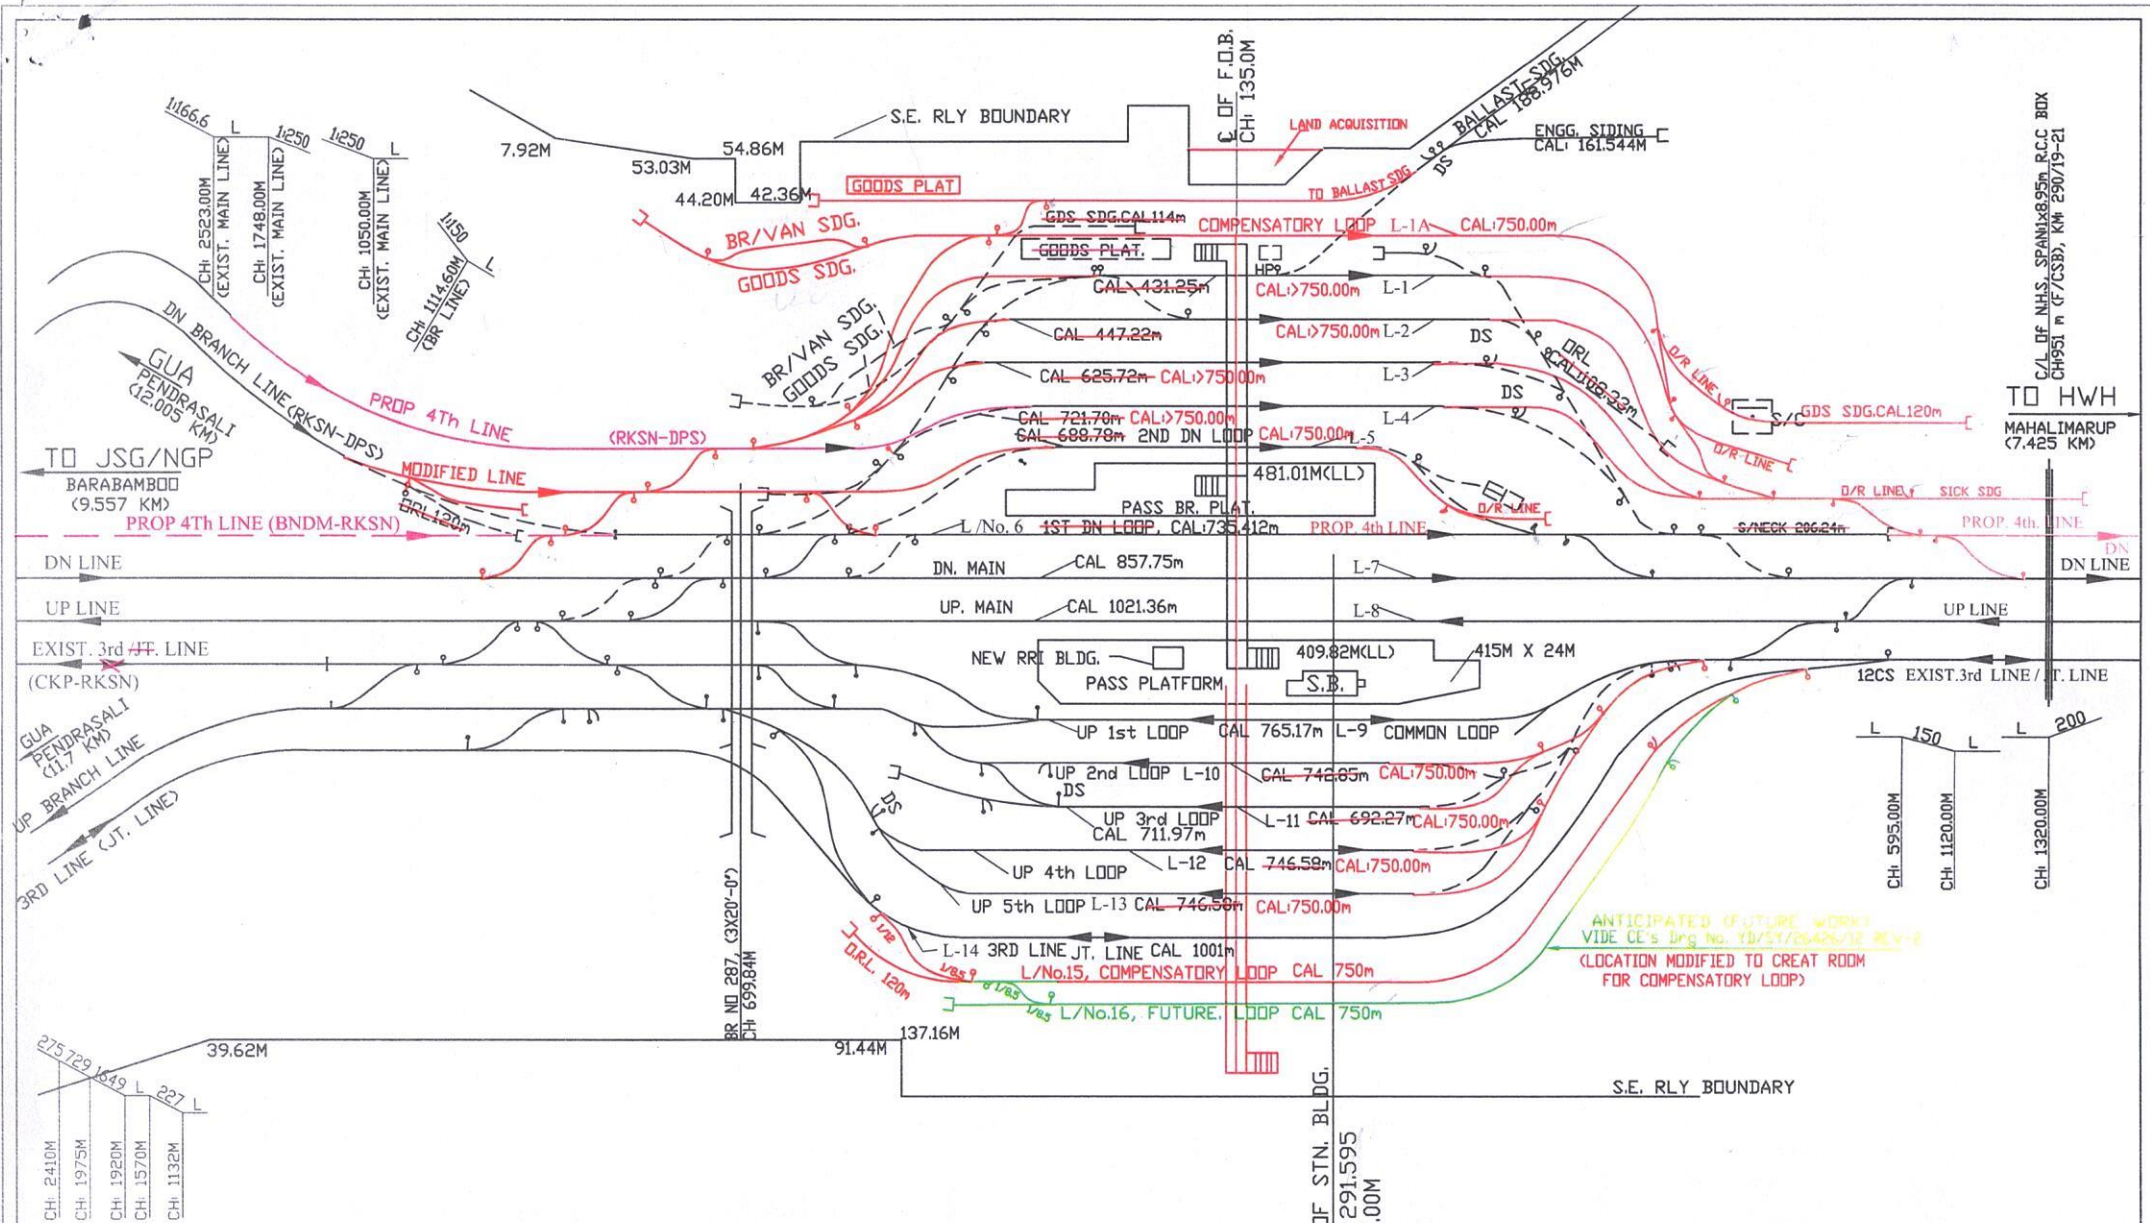

GRADIENT OF
JT/3rd LINE
(BTN. RKSJ-CKP)

LEGENDS:

1. ALL EXIST. WORKS & LINES ARE SHOWN AS BLACK FIRM LINE
2. PROP. ADTP-RKSJ 4th LINE WORKS SHOWN AS RED COLOUR
3. EXIST. LINES TO BE DISMANTLED FOR PROP. 4th LINE WORKS SHOWN AS BLACK DSHED LINE
4. PROP. RKSJ-DPS 4th LINE WORKS SHOWN AS MAGENTA COLOUR
5. PROP. RKSJ-BNDM 4th LINE WORKS SHOWN AS MAGENTA DASHED COLOUR
6. EARLIER SANCTIONED WORKS BUT NOT EXECUTED SO APR ARE SHOWN AS GREEN COLOUR
(SANCTIONED VIDE CE's No. YD/SY/27270/16, REV-1).

Bidhan
3/4/24
CTPM/GRC

CE/CON/GRC

CSTE/CON/GRC

CE/HQ/CON/GRC

REF: CE's DRG No. CE's No. YD/SY/27270/16, REV-1

SOUTH EASTERN RAILWAY

NAME OF PROJECT	ADTP-RKSJ PROP. 4th LINE & RKSJ-BNDM prop. 4th LINE Earlier Sanctioned Balance Works
NAME OF STATION	CONCEPTUAL YARD PLAN RAJKHARSWAN STATION KM. 291.595 (FROM HWH VIA TATA)
Dated : 10.03.2024 NOT TO SCALE	