


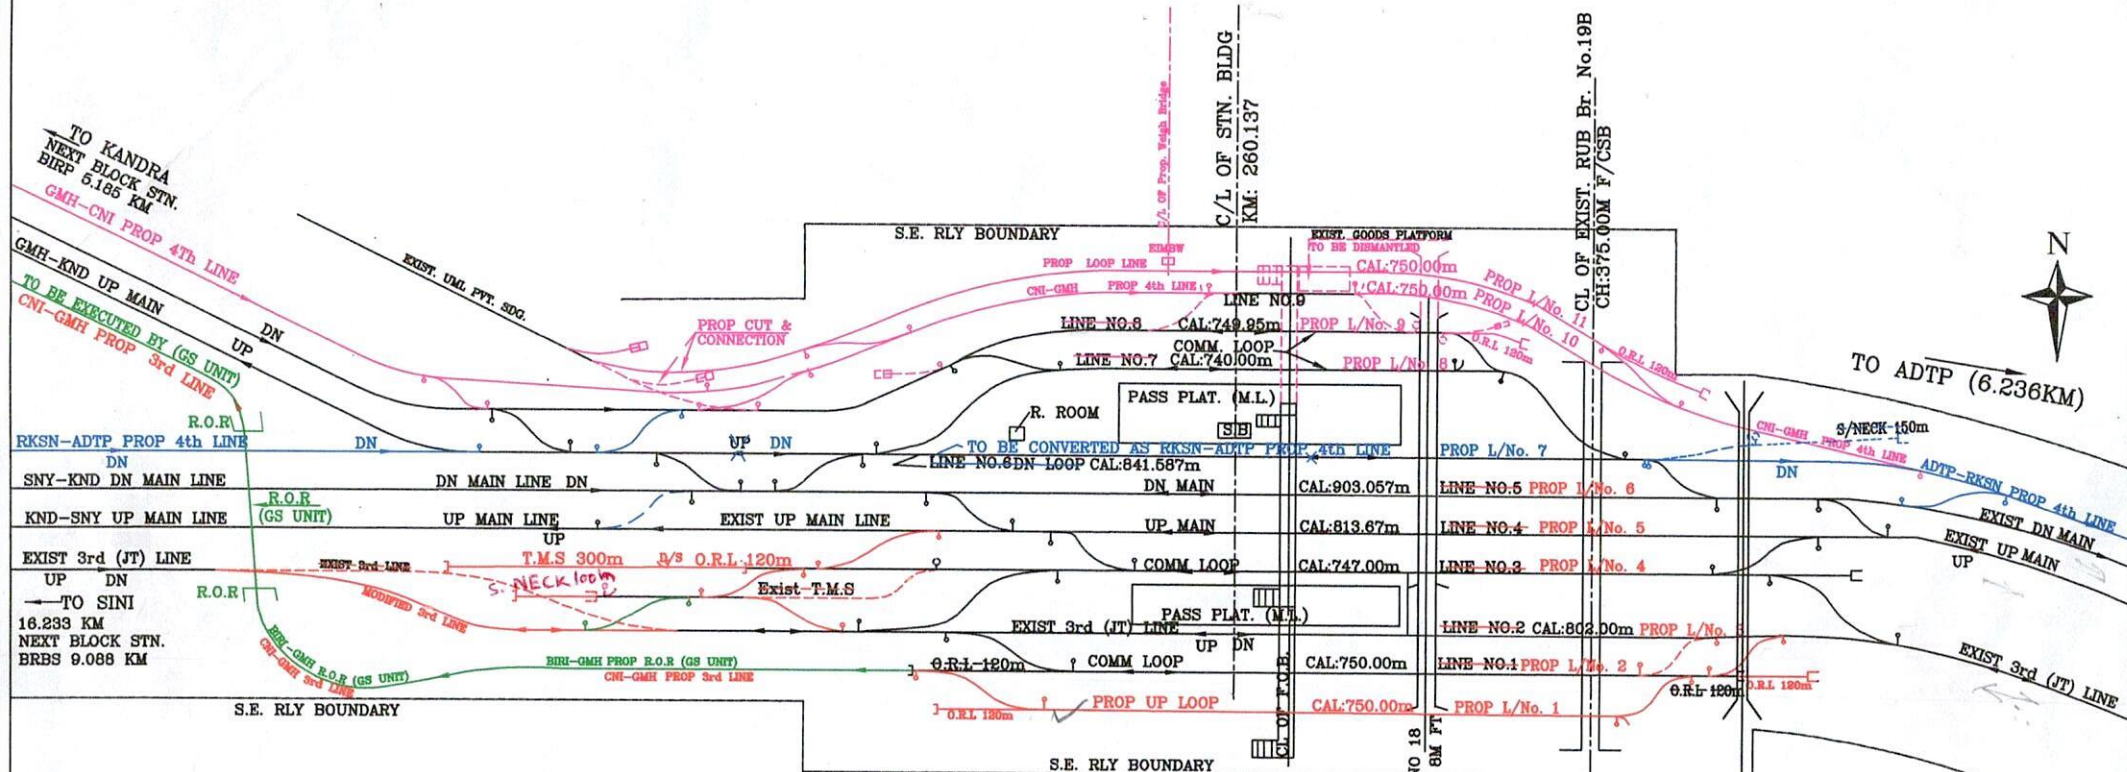

LEGENDS:

1. ALL EXIST. WORKS SHOWN AS
2. EXIST. WORKS TO BE DISMANTLED FOR BIRP-GMH FLY OVER LINE WORKS BY GS UNIT
3. PROP. BIRP-GMH FLY OVER LINE WORKS BY GS UNIT
4. EXIST. WORKS TO BE DISMANTLED FOR PROP. ADTP-RKSN 4th LINE WORKS
5. PROP. ADTP-RKSN 4th LINE WORKS
6. EXIST. WORKS TO BE DISMANTLED FOR CNI-GMH 3rd LINE
7. PROP. CNI-GMH 3rd LINE WORKS
8. EXIST. WORKS TO BE DISMANTLED FOR CNI-GMH 4th LINE
9. PROP. CNI-GMH 4th LINE WORKS SHOWN AS

IMPORTANT NOTES:-

1. PROP. BIRP-GMH FLY OVER LINE WORKS BEING DONE BY GS UNIT HAS BEEN MERGED WITH PROP. CNI - GMH 3rd LINE.
2. CAL OF ALL EXIST. & PROP. LINES ARE TO BE MORE THAN 750m EXCEPT CAL OF PROP L/No. 8, WHICH IS 740m AS EXIST.
3. PROP. ELEVATED CORRIDOR FROM GMH TO KND IN CONNECTION WITH PROP. CNI - GMH 3rd LINE HAS BEEN MERGED WITH PROP. ROR BY GS UNIT.

3/4/24
CTPM/GRC


CEE/CON/GRC

CSTE/CON/GRC

CE/CON/HQ/GRC

REF: CE's DRG No. YD/SY/26567/12 REV-5

SOUTH EASTERN RAILWAY	
NAME OF PROJECT	CNI - GMH PROP. 3rd LINE, 4th LINE & ADTP-RKSN PROP. 4th LINE BIRP - GMH FLY OVER LINE OF GS UNIT
NAME OF STATION	CONCEPTUAL YARD PLAN GAMAHARIA STATION KM. 260.137 (FROM HWH VIA TATA)
Dated 26.03.2024	NOT TO SCALE

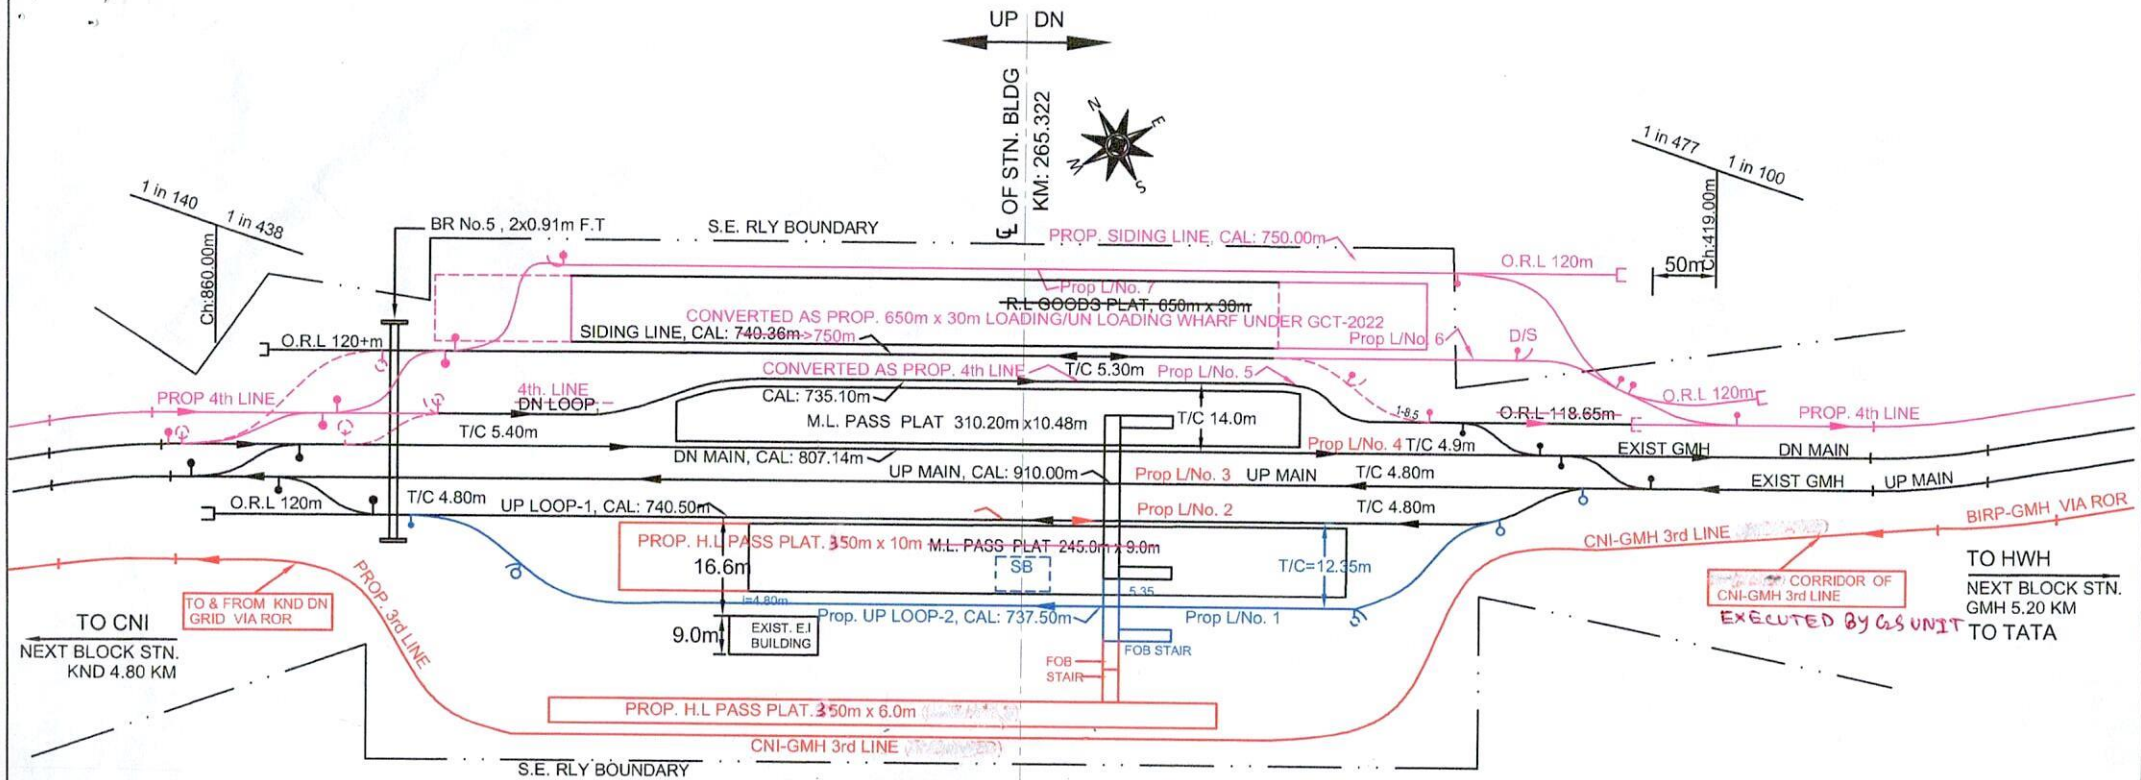

IMPORTANT NOTE:-

1. PROP. CNI - GMH 3rd LINE HAS BEEN PROPOSED AS ~~EXISTING~~ CORRIDOR FROM GMH TO KND AS DESIRED BY DY COM INFRA/GRC.
2. OTHER RELATED WORKS REGARDING INTEGRATION OF PROP. 3rd LINE HAS BEEN REMOVED FROM THE PLAN AS NOT REQUIRED. LINE NO.S HAVE BEEN RENUMBERED ACCORDINGLY.

COMPLIANCE NOTE:

The CONNECTION OF (EXIST LINE No. 5) PROP. LINE No. 6 AND PROP. LINE No. 7 WITH UP MAIN LINE HAVE NOT BEEN POSSIBLE DUE TO SPACE CONSTRAINT AND STEEPER APPROACH GRADIENTS ON EITHER END OF THE YARD.
HOWEVER THE SAID LINES PROPOSED TO BE CONNECTED WITH PROP GMH-CNI 4th LINE LINE, TO GET UP DIRECTION CONNECTION FROM GMH.

LEGENDS:

1. ALL EXIST. WORKS SHOWN AS
2. BALANCE WORKS OF CE's DRG No. YD/SY/ED/28886 /21, REV-1, SHOWN AS
3. PROP. CNI-GMH 3rd LINE WORKS ~~TO BE~~ EXECUTED BY GS UNIT
4. EXIST. WORKS TO BE DISMANTLED FOR CNI-GMH 4th LINE
5. PROP. CNI-GMH 4th LINE WORKS SHOWN AS

BASED ON CE's DRG No. YD/SY/ED/28886 /21, REV-1

SOUTH EASTERN RAILWAY

NAME OF PROJECT	GAMAHARIA TO CHANDIL PROP. 3rd LINE, 4th LINE & BIRP-GMH FLY OVER LINE OF GS UNIT
NAME OF STATION	CONCEPTUAL YARD PLAN BIRARAJPUR STATION KM. 265.322 (FROM HWH VIA TATA)

Dtd 26.03.2024

NOT TO SCALE

Bitambari
21/4/24
CTPM/GRC

CEE/CON/GRC

CSTE/CON/GRC

CE/CON/HQ/GRC


<<- TO ADRA
<<- TO CHANDIL
NEXT BLOCK STN.
(KUNKI 3.272 Km)

BR. NO. 327B (EXIST. ROB)
RLY SPAN:(1x21.5m+1X15.0m)PSC GIRDER

BR. NO. 327
2 X 3'-0" F.T.

CL OF EXIST. F.O.B
TO BE DISMANTLED

CL OF KND STN. BLDG
KM: 271.000 F/HWH
CL OF PROP. F.O.B
3.0m WIDE RDSO STANDARD

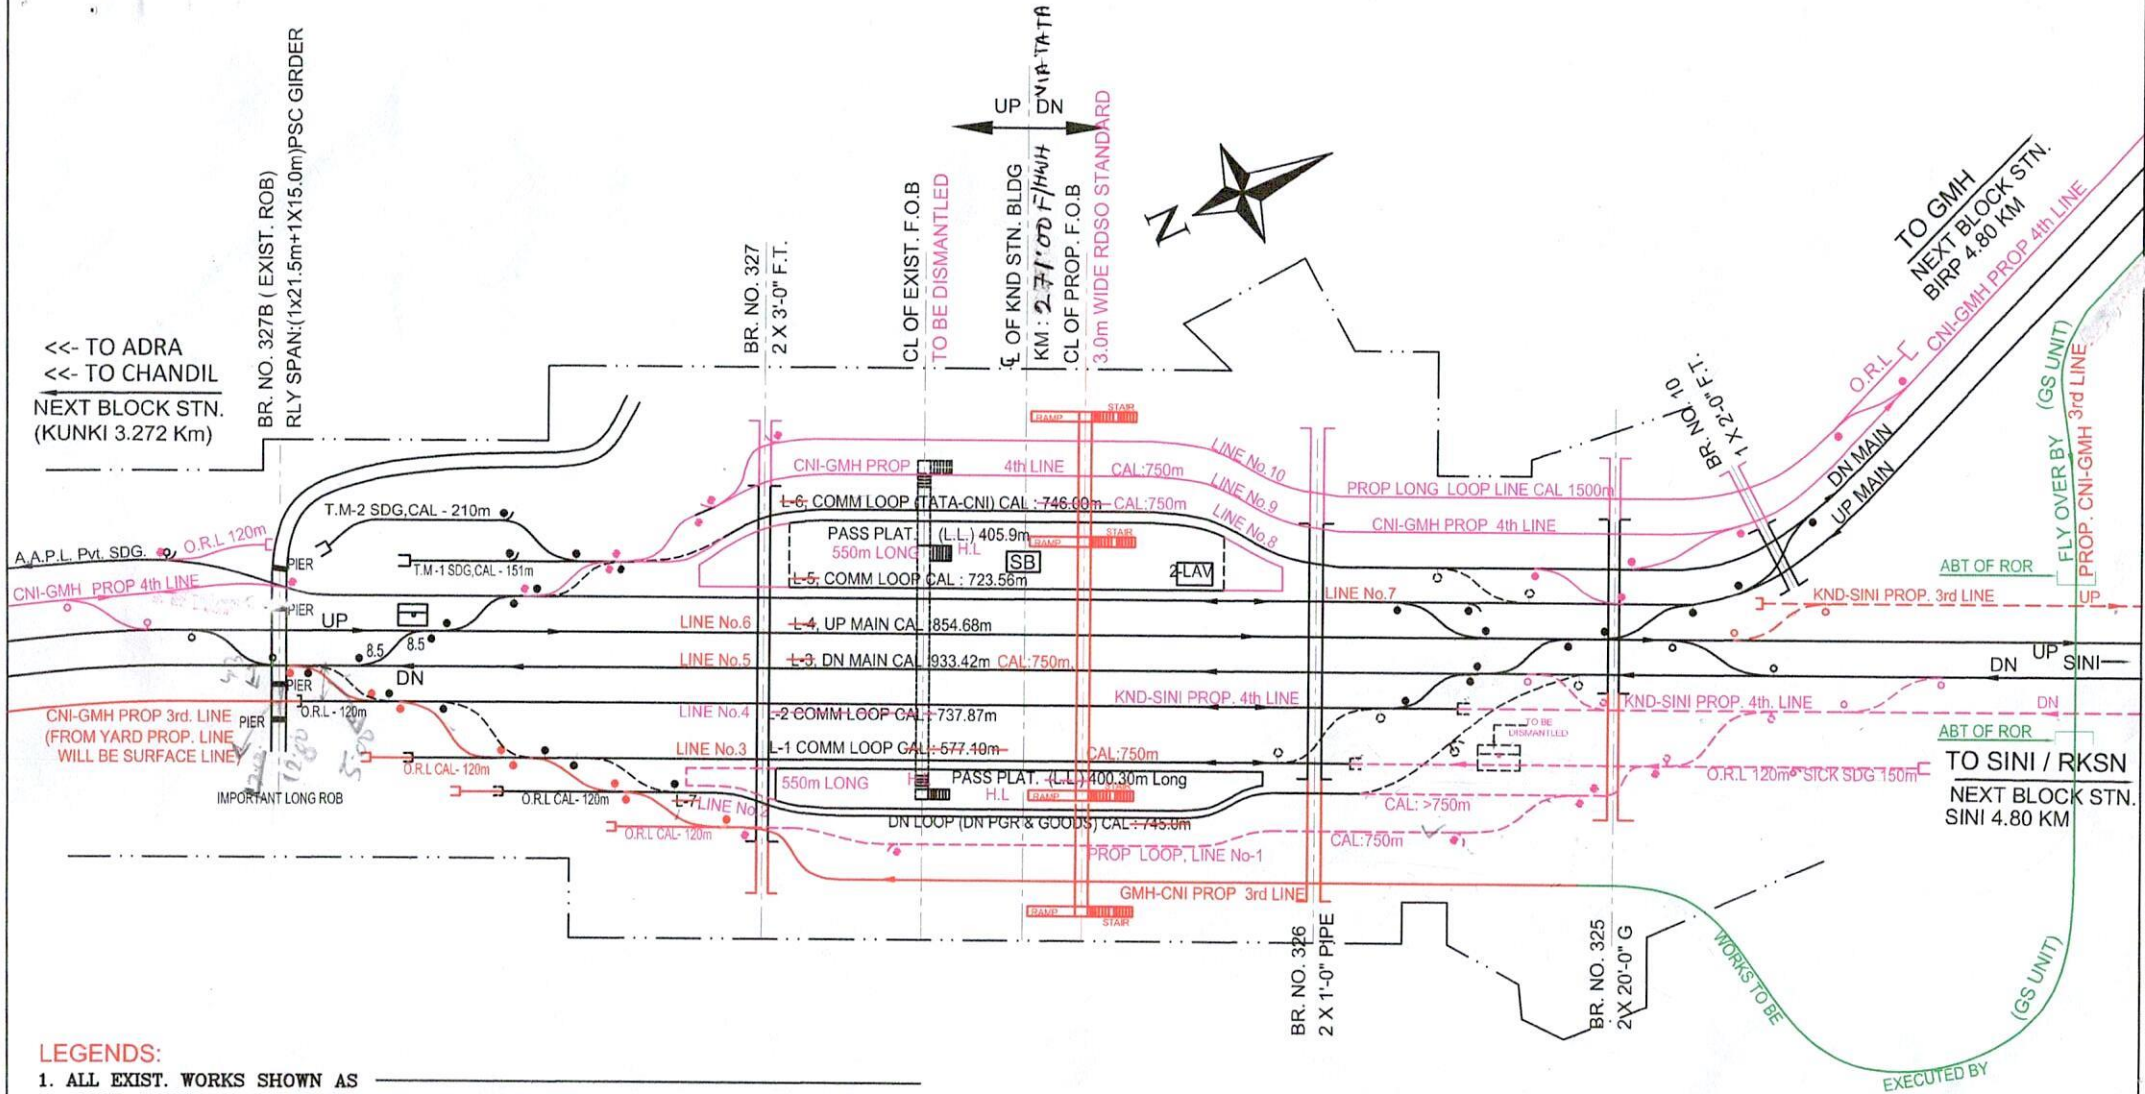

LEGENDS:

1. ALL EXIST. WORKS SHOWN AS _____
2. EXIST. WORKS TO BE DISMANTLED ARE SHOWN AS BLACK DASHED LINES _____
3. PROP. KND-GMH _____ LINE (PART OF CNI-KND-GMH) 3rd LINE
TO BE EXECUTED BY GS UNIT
4. PROP. CNI-KND-GMH 3rd LINE SHOWN AS _____
5. PROP. CNI-GMH 4th LINE WORKS SHOWN AS _____
6. PROP. KND-SINI PROP. 3rd LINE WORKS AS _____
7. PROP. KND-SINI PROP. 4th LINE WORKS AS _____

Boh...
31/12/24
CTPM/GRC

...
CEE/CON/GRC


...
CSTE/CON/GRC

...
CE/CON/HQ/GRC

REF : CE's No.- YD/SY/ED/28216/19, REV-1

SOUTH EASTERN RAILWAY

NAME OF PROJECT	GAMAHARIA TO CHANDIL 3RD LINE & 4TH LINE WORK KANDRA TO SINI 3RD LINE & 4TH LINE WORK
NAME OF STATION	CONCEPTUAL YARD PLAN KANDRA STATION KM. 271.000 (FROM HWH VIA TATA)
Dated 26.03.2024	NOT TO SCALE

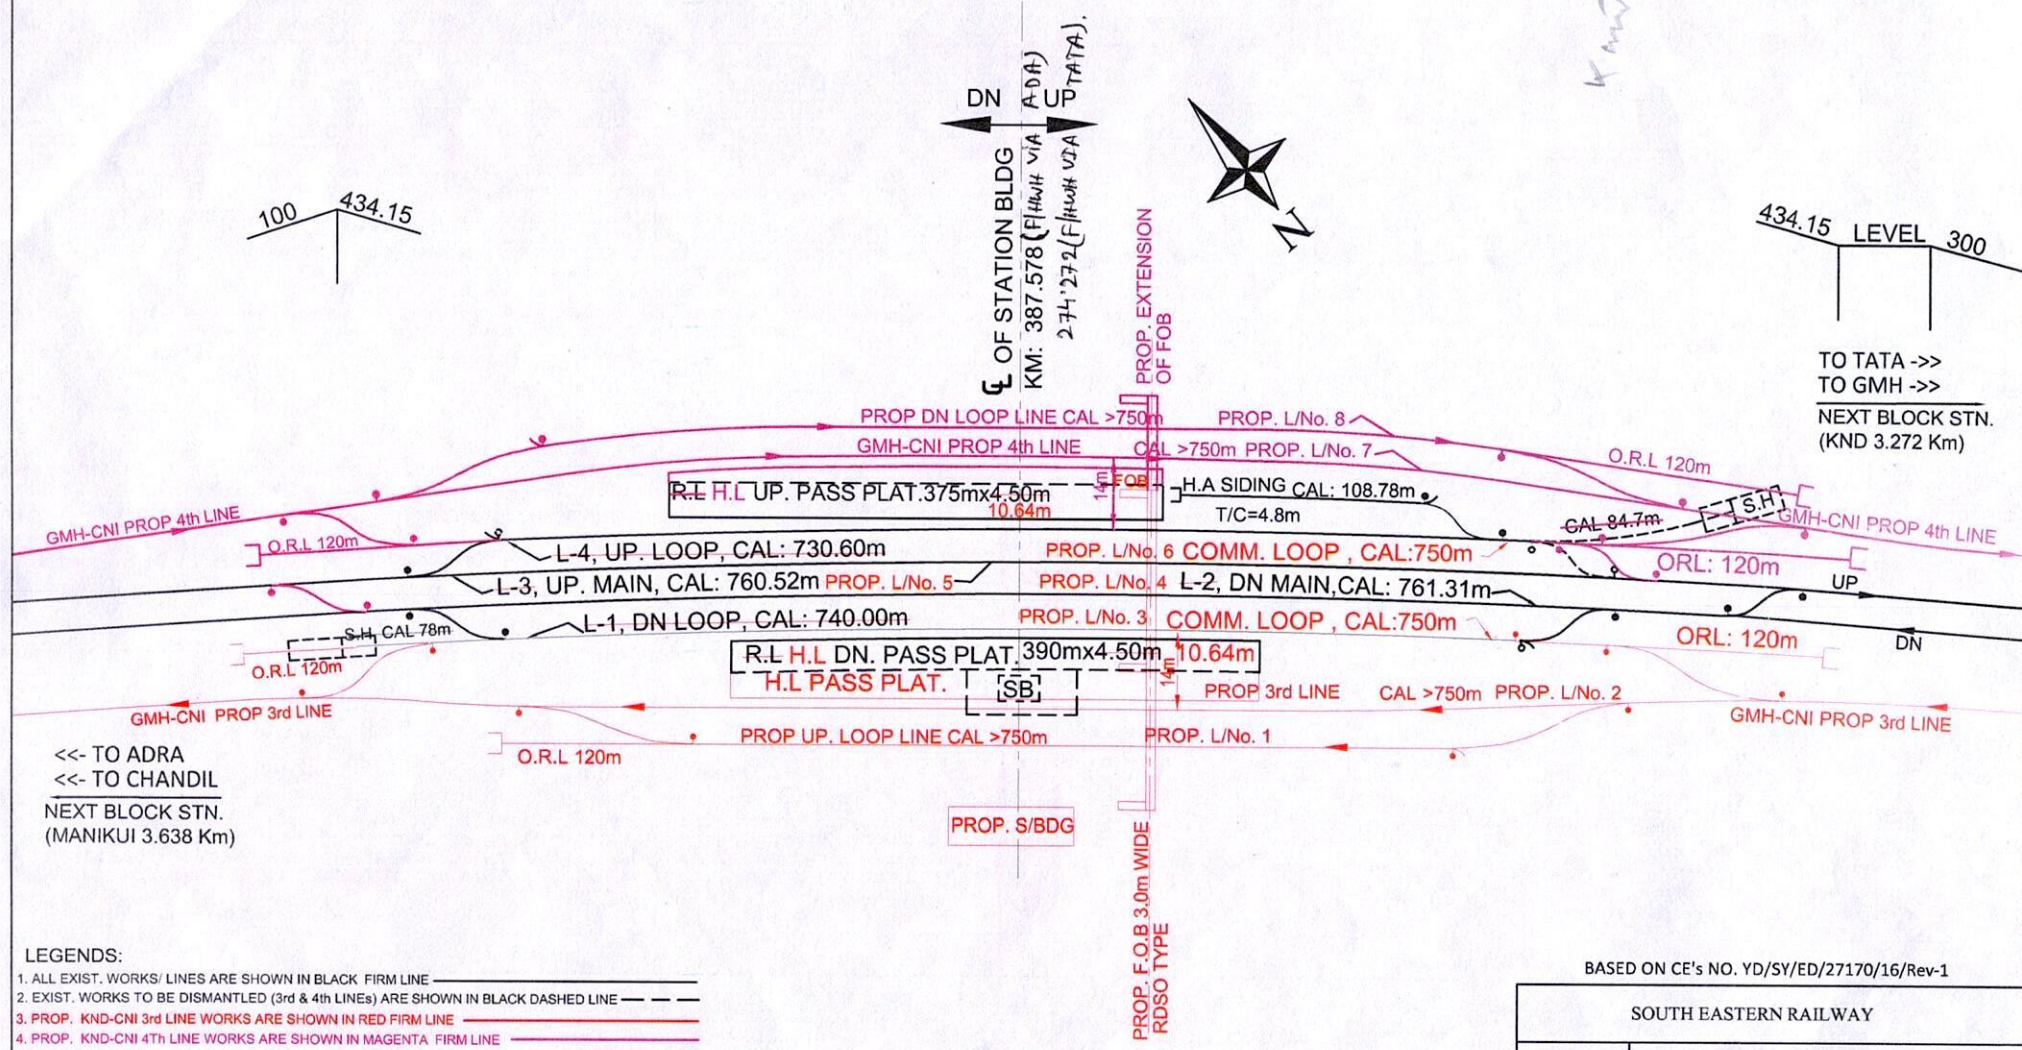


- LEGENDS:**
1. ALL EXIST. WORKS/ LINES ARE SHOWN IN BLACK FIRM LINE
 2. EXIST. WORKS TO BE DISMANTLED (3rd & 4th LINES) ARE SHOWN IN BLACK DASHED LINE
 3. PROP. KND-CNI 3rd LINE WORKS ARE SHOWN IN RED FIRM LINE
 4. PROP. KND-CNI 4th LINE WORKS ARE SHOWN IN MAGENTA FIRM LINE

B. S. M. L. 3/4/24 CTPM/GRC
 [Signature] CEE/CON/GRC
 [Signature] CSTE/CON/GRC
 [Signature] CE/CON-II/GRC

BASED ON CE's NO. YD/SY/ED/27170/16/Rev-1

SOUTH EASTERN RAILWAY	
NAME OF PROJECT	GAMAHARIA TO CHANDIL 3RD LINE & 4TH LINE WORK
NAME OF STATION	CONCEPTUAL YARD PLAN KUNKI STATION KM. 387.578 (FROM HWH VIA ADRA)
Dated : 04.03.2024	NOT TO SCALE

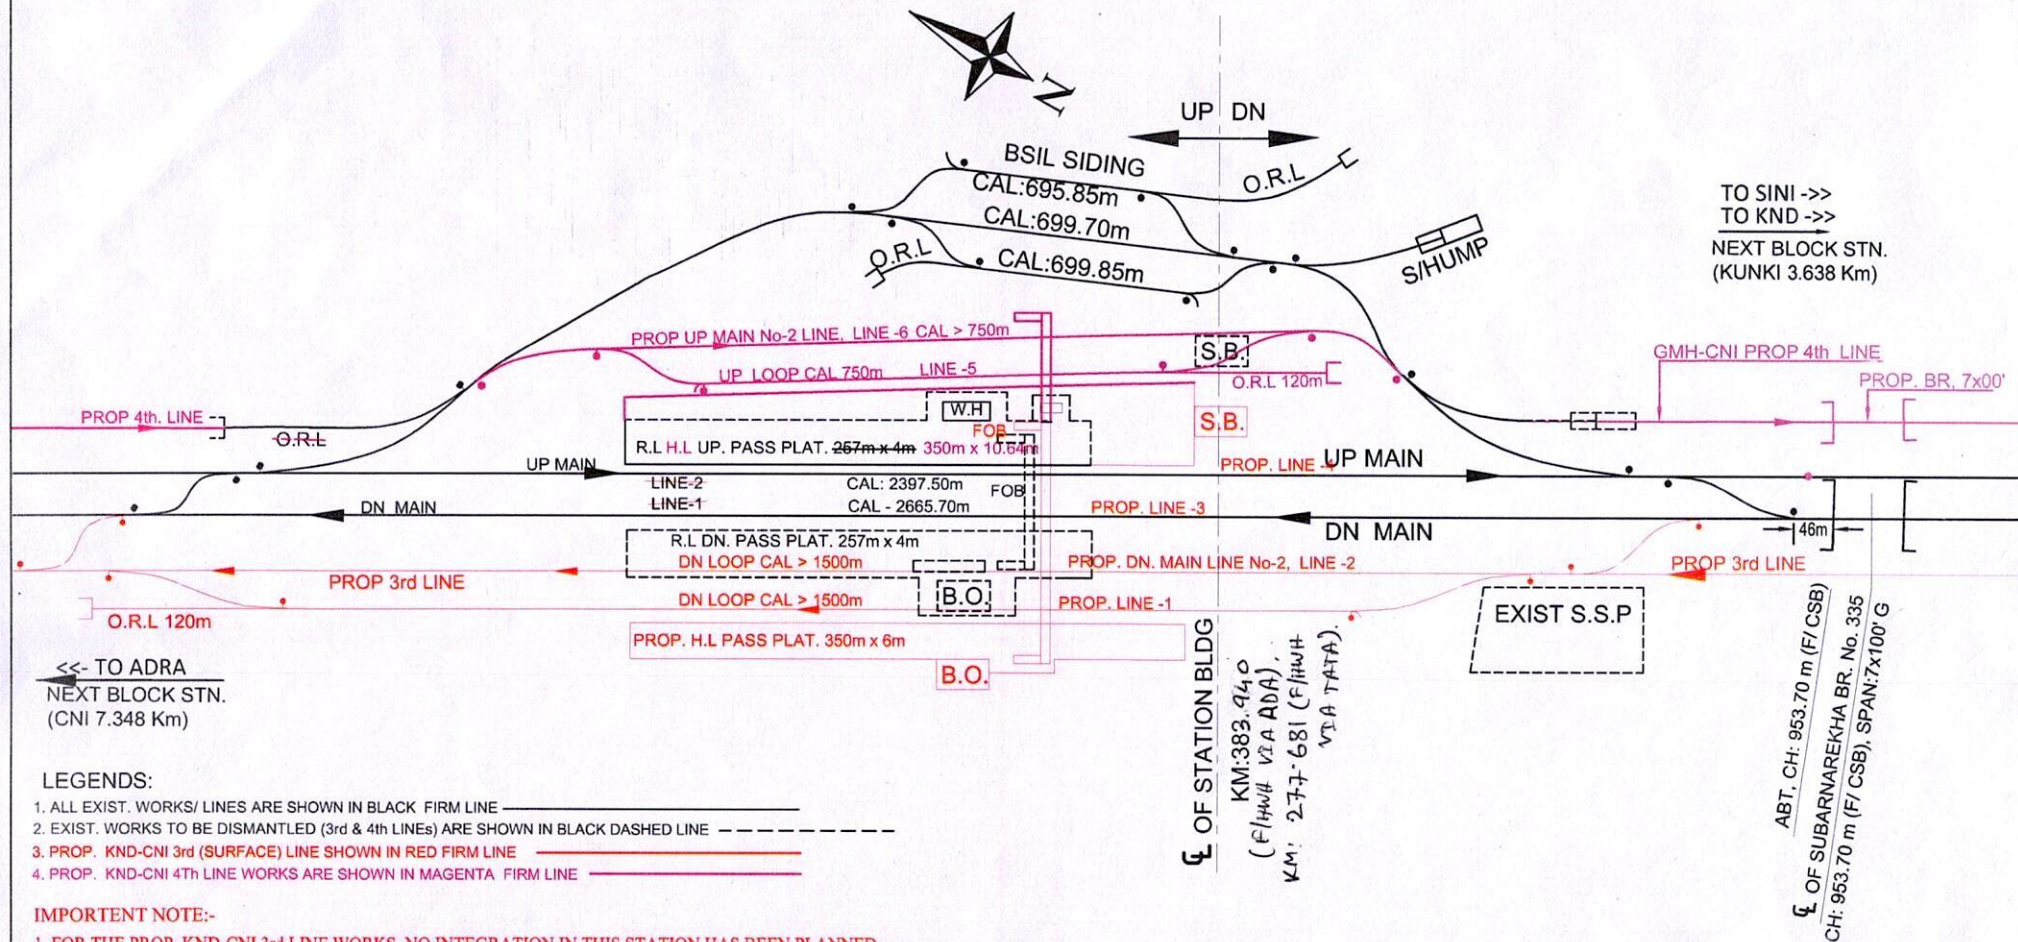

BASED ON CE's NO. YD/SY/ED/27170/16/Rev-1


SOUTH EASTERN RAILWAY	
NAME OF PROJECT	GAMAHARIA TO CHANDIL 3RD LINE & 4TH LINE WORK
NAME OF STATION	CONCEPTUAL YARD PLAN MANIKUI STATION KM. 277.681 (FROM HWH VIA TATA)
Dated : 04.03.2024	NOT TO SCALE

B. B. B. B.
21/4/24
CTPM/GRC

CEE/CON/GRC

CSTE/CON/GRC

CE/CON-II/GRC

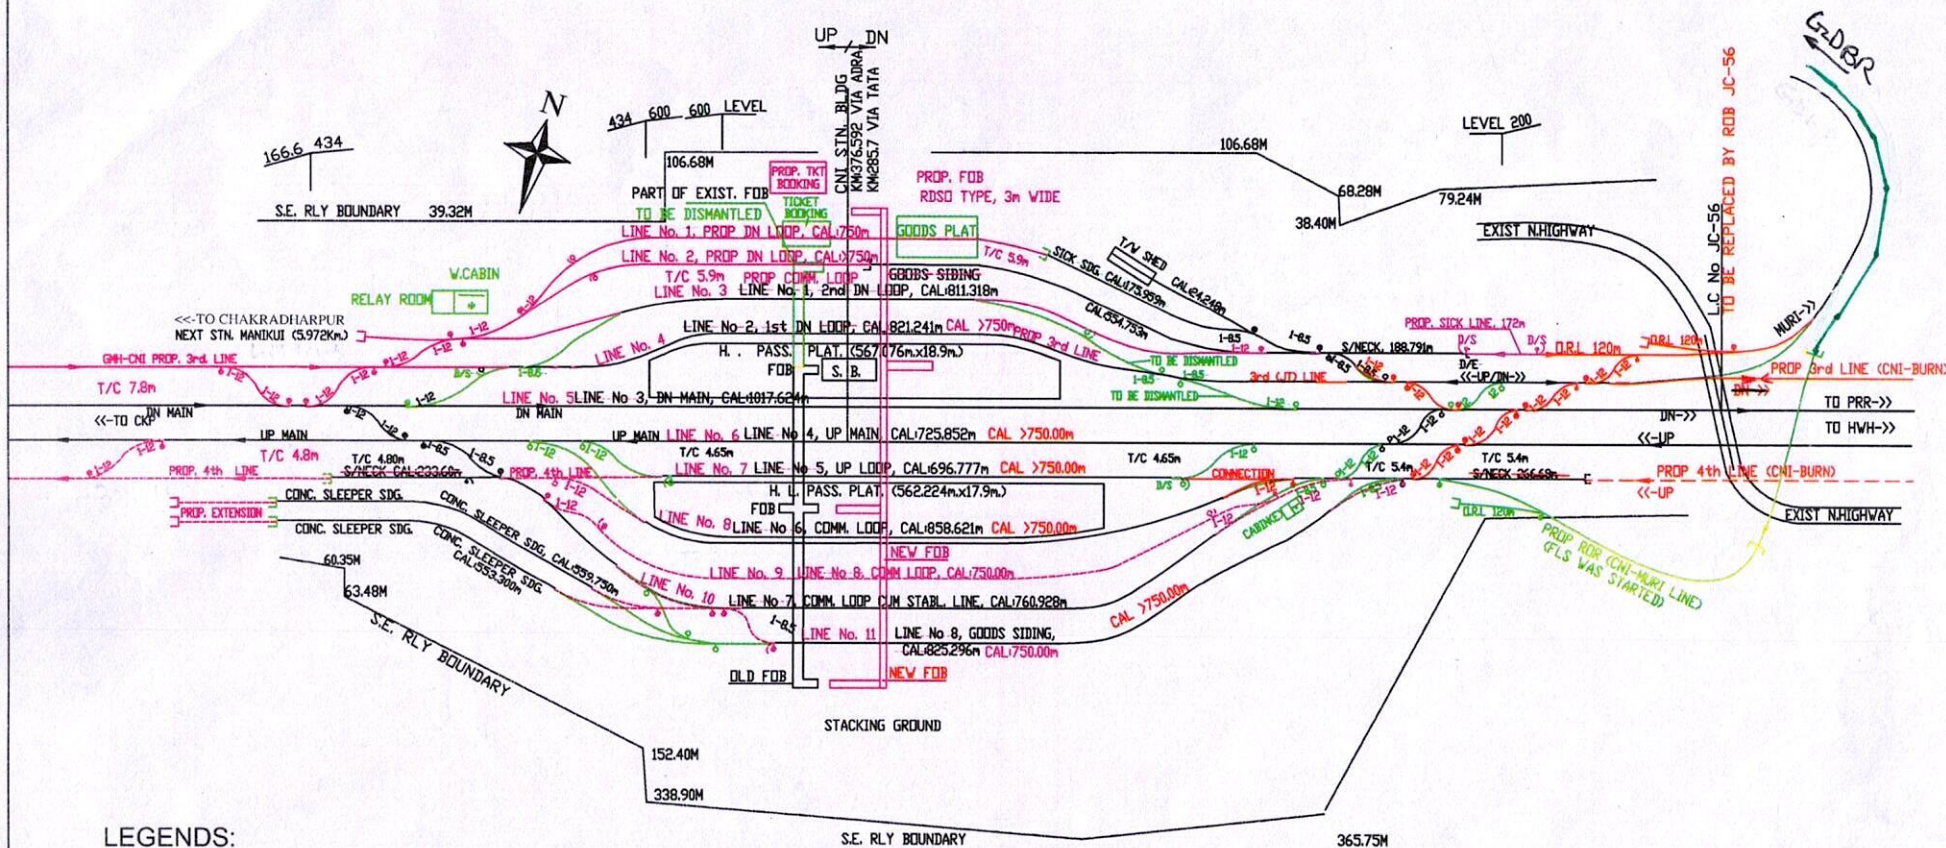

LEGENDS:

1. ALL EXIST. WORKS SHOWN AS _____
2. EXIST. WORKS TO BE DISMANTLED (CNI-BURN 3rd LINE) SHOWN AS -----
3. PROP. CNI-BURN 3rd LINE WORKS SHOWN AS _____
4. EXIST. WORKS TO BE DISMANTLED (KND-CNI 3rd/4th LINE) SHOWN AS -----
5. PROP. KND-CNI 3rd LINE WORKS SHOWN AS _____
6. PROP. KND-CNI 4th LINE WORKS SHOWN AS -----
7. PROP. CNI-BURN 4th LINE WORKS SHOWN AS _____
8. PROP. KND-CNI & CNI- BURN 3rd LINE & 4th LIEN WORKS TO BE EXECUTED IN SINGLE PHASE TO AVOID MULTIPLE N.I WORKS SUBJECT TO THE SANTIONING OF THE WORKS.

BASED ON CE's No.- YD/SY/25579/07, ALT-3

SOUTH EASTERN RAILWAY	
NAME OF PROJECT	(i) GAMAHARIA TO CHANDIL (ii) CHANDIL TO BURNPUR 3RD LINE & 4TH LINE WORK
NAME OF STATION	CONCEPTUAL YARD PLAN CHANDIL STATION KM. 285.708 (FROM HWH VIA TATA)
Dated : 04.03.2024	NOT TO SCALE

Bibhuti
31/1/24
CTPM/GRC

CEE/CON/GRC

CSTE/CON/GRC

CE/CON-II/GRC