

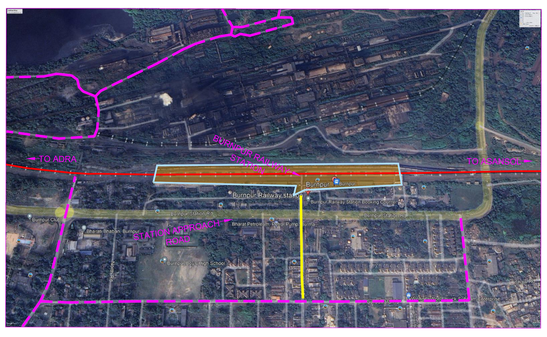


1. KEY PLAN BURNPURPUR STATION

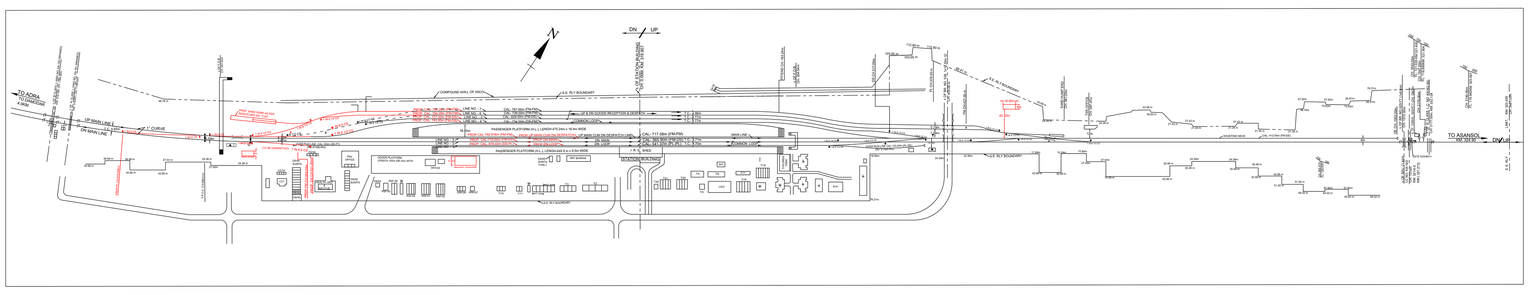

2. LAND PLAN WITH EXISTING STATION FACILITIES
BURNPUR STATION

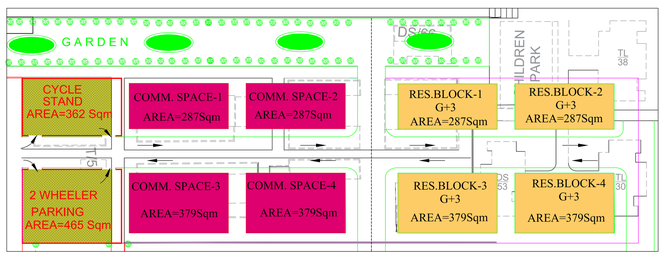

4. RE-LOCATION PLAN
BURNPUR STATION



PROP.STATION FACADE

LEGEND	
S.NO.	DESCRIPTION
1	COMM. BLDG.
2	RESIDENTIAL QUATERS
3	COAL SIDING / GOODS PF.
4	GREEN PARK
5	PARKING
6	SOLAR PANNEL
7	RAIN WATER HARVESTING
8	PAVED SURFACE
9	VACANT LAND FOR FUTURE DEVELOPMENT
10	BUILDING UNDER RAILWAY OPERATION
11	STATION AREA DEVELOPMENT
12	PASSENGER PLATFORM

AREA STATEMENT- STATION PLOT		
S.No.	Description	Area in SQMT.
1	Total Plot Area(In Sqm.)	100576
2	Area under Railway operation (in Sqm.)	28747
3	Net area under Real Estate development	3744
4	Ground coverage	1124
5	Ground coverage achived	896
6	FAR Applicable	8424
7	FAR Achived	7488
8	Height restrictions	20.94
9	Area under physical infrastructure	18559
10	Area under green	3653
11	Area under Roads	3865
12	Area under parking and circulation	2907
13	Area under residential development	1332
14	Area under commercial & social infra structure development	9040

TECHNICAL SERVICE BLOCKS

POWER SUPPLY
1. LOCAL SUPPLY FROM IISCO (SAIL) 3 Phase/ 415V (LT)
1. A.T. SUPPLY OF 2 X10 KVA FOR PLATFORM LIGHTING AND SIGNALING PURPOSE

SEWAGE
1. BIO TOILET FOR 500 USER

WATER SUPPLY
1. FILTER WATER SUPPLIED FROM IISCO AT GROUND TANK OF CAPACITY 36300 GALLONS.
2. EXISTING MOND BLOCK PUMP OF 15 HP CAPACITY FOR COLONY SUPPLY.
3. EXISTING ELECTRO CHLORINATION PLANT (MAC-500)

NOTES:
1. ALL DIMENSIONS ARE IN MTR.OTHERWISE SPECIFIED.
2. PROP. WORK SHOWN IN RED COLOUR.
3. DISMANTLING WORK SHOWN IN BLACK DOTTED.
4. FUTURE WORKS SHOWN IN GREEN COLOR.
5. DISTANCE OF RLY. BOUNDARY LINE TAKEN FROM C.L OF UP MAIN LINE.
6. DISTANCE OF RLY. BOUNDARY LINE TAKEN FROM C.L OF UP MAIN LINE.

3. MASTER PLAN
BURNPUR STATION

NOTE:

QUARTER NOS.T-2,T-3, T-4, T-5, T-6, T-11,T-12,LC-4, DS-51,DS-53, DS-66, TL-30 AND TL-38 NEED TO BE DEMOLISHED ON MAIN ENTRANCE OF THE BURNPUR STATION.

SIGNATURE BLOCK		
DIVISIONAL OFFICER	NAME	SIGNATURE
DRM/ADRA	SUMIT NARULA	SUMIT NARULA
CPM/GSU	K.C.SHARMA	Kailash Chand Sharma
SR.DEN(CO)/ADRA	P.P.KUMAR	PREM PRAKASH KUMAR
SR.DOM(CO)/ADRA	S.K.VERMA	Sachendra Kumar Verma
SR.DSTE/ADRA	K.K.GARG	KAUSHAL KUMAR GARG
SR.DCM(CO)/ADRA	VIKAS KUMAR	VIKAS KUMAR
SR.DEE(G)/ADRA	A.B.KHAN	ABDUL BARK KHAN
DEN(CENT)/ADRA	B.P. SINGH	BHANU PRATAP SINGH


CLIENT:
SOUTH EASTERN RAILWAY

CONSULTANT :-
SYSTEM ENGINEERS (INDIA)
78, Bansdroni Park,
Kolkata - 700070.
Emai-system.enggindia@gmail.com


PROJECT :
PREPARATION OF FACADE DEVELOPMENT DRAWING, LANDSCAPING DRAWINGS OF CIRCULATING AREA INCLUDING PARKING ARRANGEMENTS DETAILS, HORTICULTURE WORK DETAILS AND OTHER MISCELLANEOUS BUILT-UP STRUCTURE DETAILS UNDER AMRIT BHARAT STATION SCHEME FOR 15 STATIONS (ADRA,BOKARO,BHAGA,BISHNUPUR, GARBETA, CHANDRAKONA,SALBONI, JOYCHANDIPAHAR, MADHUKUNDA,BANKURA, BARABHUM,CHANDIL,ANARA,BURNPUR,PURULIA) OF ADRA DIVISION

SHEET-1/3


SOUTH EASTERN RAILWAY					
ADRA DIVISION DRG.No. CPM/ADA/11/24					
MASTER PLAN					
BURNPUR RAILWAY STATION AMRIT BHARAT STATION SCHEME FOR 16 STATIONS IN ADRA DIVISION.					
DATE :	03.07.2024			SCALE: N.T.S.	STATUS
REV.	R0	R1	R2		

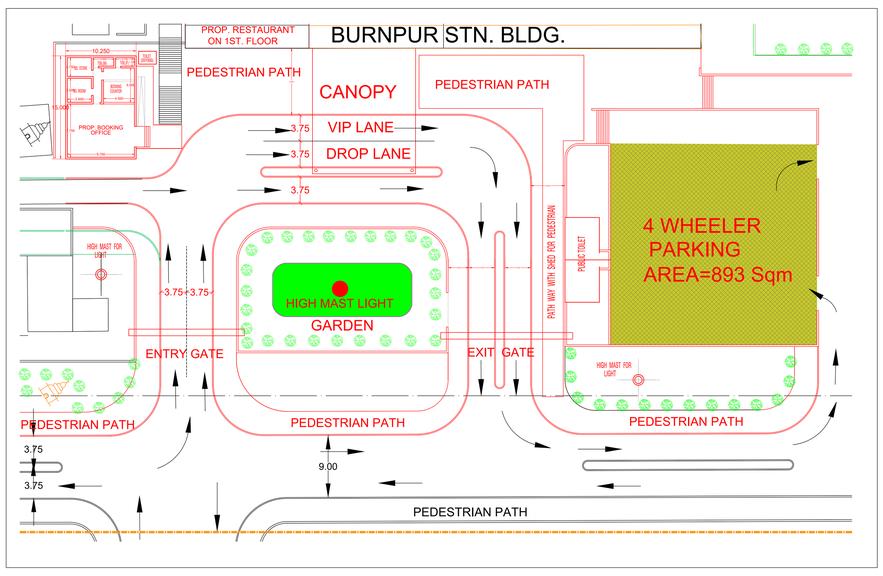


1. CIRCULATING AREA
BURNPUR STATION

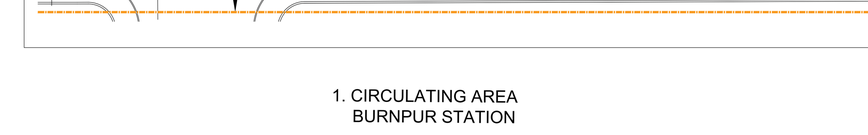

BURNPUR STATION

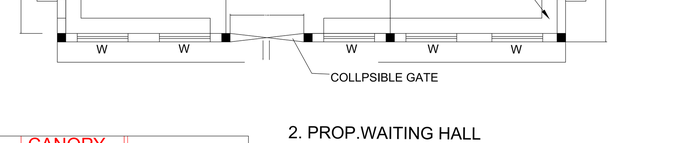

2. PROP.WAITING HALL
BURNPUR STATION

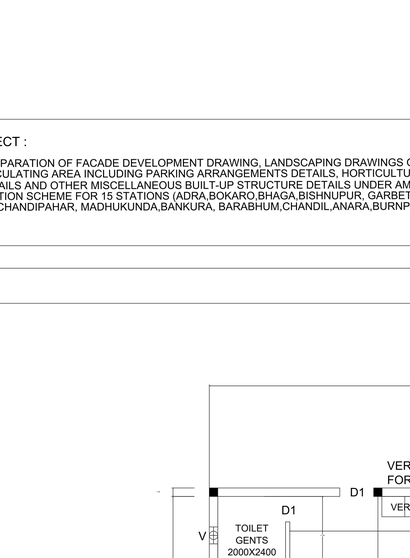

3. LANDSCAPE PLAN
BURNPUR STATION

SIGNATURE BLOCK		
DIVISIONAL OFFICER	NAME	SIGNATURE
DRM/ADRA	SUMIT NARULA	SUMIT NARULA
CPM/GSU	K.C.SHARMA	Kailash Chand Sharma
SR.DEN(CO)/ADRA	P.P.KUMAR	PREM PRAKASH KUMAR
SR.DOM(CO)/ADRA	S.K.VERMA	Sachendra Kumar Verma
SR.DSTE/ADRA	K.K.GARG	KAUSHAL KUMAR GARG
SR.DCM(CO)/ADRA	VIKAS KUMAR	VIKAS KUMAR
SR.DEE(G)/ADRA	A.B.KHAN	ABDUL BARK KHAN
DEN(CENT)/ADRA	B.P. SINGH	BHANU PRATAP SINGH


CLIENT:
SOUTH EASTERN RAILWAY

CONSULTANT :-
SYSTEM ENGINEERS (INDIA)
78, Bansdroni Park,
Kolkata - 700070.
Emai-system.enggindia@gmail.com


PROJECT :
PREPARATION OF FACADE DEVELOPMENT DRAWING, LANDSCAPING DRAWINGS OF CIRCULATING AREA INCLUDING PARKING ARRANGEMENTS DETAILS, HORTICULTURE WORK DETAILS AND OTHER MISCELLANEOUS BUILT-UP STRUCTURE DETAILS UNDER AMRIT BHARAT STATION SCHEME FOR 15 STATIONS (ADRA,BOKARO,BHAGA,BISHNUPUR, GARBETA, CHANDRAKONA,SALBONI, JOYCHANDIPAHAR, MADHUKUNDA,BANKURA, BARABHUM,CHANDIL,ANARA,BURNPUR,PURULIA) OF ADRA DIVISION

SHEET-2/3

SOUTH EASTERN RAILWAY					
ADRA DIVISION DRG.No. CPM/ADA/11/24					
MASTER PLAN					
BURNPUR RAILWAY STATION AMRIT BHARAT STATION SCHEME FOR 16 STATIONS IN ADRA DIVISION.					
DATE :	03.07.2024			SCALE: N.T.S.	STATUS
REV.	R0	R1	R2		

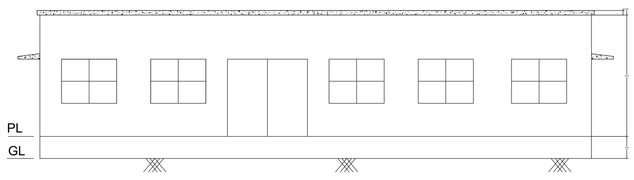

FRONT ELEVATION
(ENLARGED VIEW)

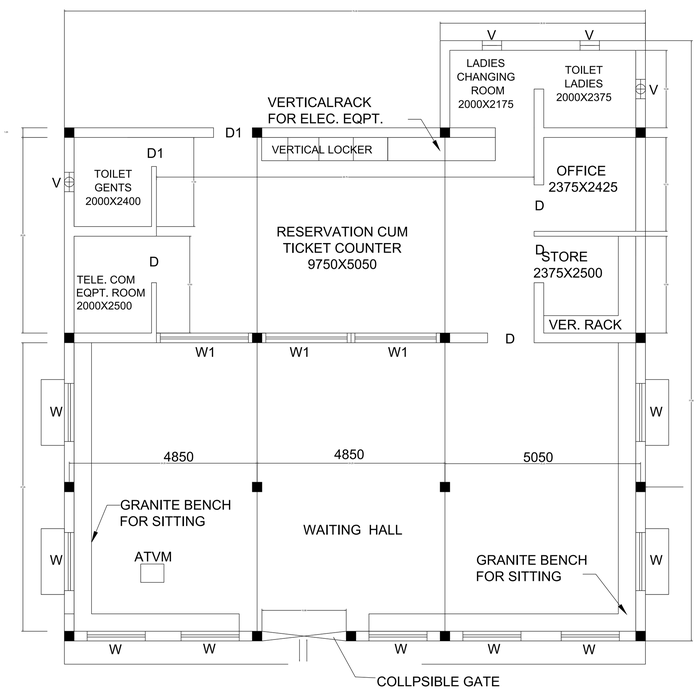

GROUND FLOOR PLAN.
ENLARGED VIEW (N.T.S.)





PERSPECTIVE VIEW

SIGNATURE BLOCK		
DIVISIONAL OFFICER	NAME	SIGNATURE
DRM/ADRA	SUMIT NARULA	SUMIT NARULA
CPM/GSU	K.C.SHARMA	Kailash Chand Sharma
SR.DEN(CO)/ADRA	P.P.KUMAR	PREM PRAKASH KUMAR
SR.DOM(CO)/ADRA	S.K.VERMA	Sachendra Kumar Verma
SR.DSTE/ADRA	K.K.GARG	KAUSHAL KUMAR GARG
SR.DCM(CO)/ADRA	VIKAS KUMAR	VIKAS KUMAR
SR.DEE(G)/ADRA	A.B.KHAN	ABDUL BARK KHAN
DEN(CENT)/ADRA	B.P. SINGH	BHANU PRATAP SINGH

CLIENT:
SOUTH EASTERN RAILWAY

CONSULTANT :-
SYSTEM ENGINEERS (INDIA)
78, Bansdroni Park,
Kolkata - 700070.
Emai-system.enggindia@gmail.com

PROJECT :
PREPARATION OF FACADE DEVELOPMENT DRAWING, LANDSCAPING DRAWINGS OF CIRCULATING AREA INCLUDING PARKING ARRANGEMENTS DETAILS, HORTICULTURE WORK DETAILS AND OTHER MISCELLANEOUS BUILT-UP STRUCTURE DETAILS UNDER AMRIT BHARAT STATION SCHEME FOR 15 STATIONS (ADRA,BOKARO,BHAGA,BISHNUPUR, GARBETA, CHANDRAKONA,SALBONI, JOYCHANDIPAHAR, MADHUKUNDA,BANKURA, BARABHUM,CHANDIL,ANARA,BURNPUR,PURULIA) OF ADRA DIVISION

SHEET-3/3

SOUTH EASTERN RAILWAY					
ADRA DIVISION DRG.No. CPM/ADA/11/24					
MASTER PLAN					
BURNPUR RAILWAY STATION AMRIT BHARAT STATION SCHEME FOR 16 STATIONS IN ADRA DIVISION.					
DATE :	03.07.2024			SCALE: N.T.S.	STATUS
REV.	R0	R1	R2		